

WAYNE
N 169
5-27-74

MISSISSIPPI
BOARD OF WATER COMMISSIONERS
416 North State Street
Jackson, Mississippi 39201

WATER WELL DRILLERS LOG

May 27 1974 Robert D. Williams & Sons Wayne
date well completed firm name county well located

LANDOWNER: Sam Smith

description of formations encountered

from

to

At 3 Waynesboro, Miss
(mailing address)

sand & chalk
sand
chalk
rock & glass
blue chalk
Waynesboro

0 2.5
23 33
33 35
35 53
52 92
98 128

WELL LOCATION:

sec. 10 T. 20 N. R. 7 E. S. 1 W. 1 miles W of Waynesboro
(distance) (direction) (nearest town)

first circulation at 38'

WELL PURPOSE: home
(home, irrigation, municipal, industrial)

WELL COMPLETION DATA:

- (1) diameter (inches) 2"
- (2) total depth (feet) 128
- (3) static water level (feet) 25 (below/above top of ground)
- (4) casing steel 99'
(material) (depth)
2" (size) if telescope see back.
- (5) screen none used
(length) (depth to top)
(size) (material)
- (6) pump Custom 2 1/2 gpm
(HP) (yield/gpm)
(type power)
- (7) electric log _____
(yes or no)
(organization running log)
- (8) how well bottom plugged _____
open

CODED


RECEIVED
JUL 21 1974

DRILLERS REMARKS:

MISS. BD. OF WATER COMM

If well telescopes please sketch and show depths.

GROUND LEVEL

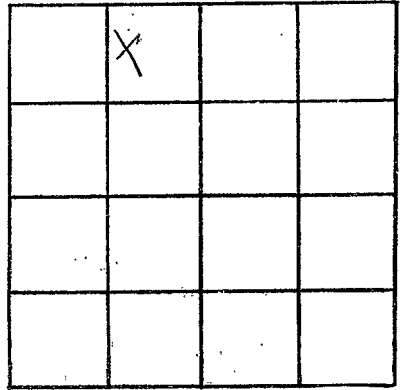

SECTION 10

Please indicate well location X.

ADDITIONAL INFORMATION

Lined area for additional information.

If more than one screen, show locations of each on sketch.