

MISSISSIPPI  
BOARD OF WATER COMMISSIONERS  
416 North State Street  
Jackson, Mississippi 39201

CODED

WAYNE  
N 170

WATER WELL DRILLERS LOG

7-5-74

July 5 1974  
date well completed

74 Roy V. Westwater wells wayne  
firm name county well located

LANDOWNER: M. L. McGill

description of formations encountered

from to

Rt 3 Box 154 Waynesboro

sand	0	12
sandy clay	12	32
sand	32	135
blue clay	135	175
sand	175	185

(mailing address)

WELL LOCATION:

sec. 16 T. 8 N. R. 7 E  
S W  
4 miles W of Waynesboro  
(distance) (direction) (nearest town)

WELL PURPOSE: home  
(home, irrigation, municipal, industrial)

WELL COMPLETION DATA:

- diameter (inches) 2
- total depth (feet) 185
- static water level (feet) 8110 below above top of ground.
- casing PVC, 175 (material) (depth)  
(size) if telescope see back.
- screen 10, 125 (length) (depth, to top)  
1/4 St Steel (size) (material)
- pump 1, 4 (HP) (yield gpm)  
REA (type power)
- electric log NO (yes or no)

CODED

(organization running log)

(8) how well bottom plugged washed

DRILLERS REMARKS:


RECEIVED  
AUG 6 1974

AUG - 6 1974

MISS. BO. OF WATER COMM.

If well telescopes please sketch and show depths.

GROUND LEVEL

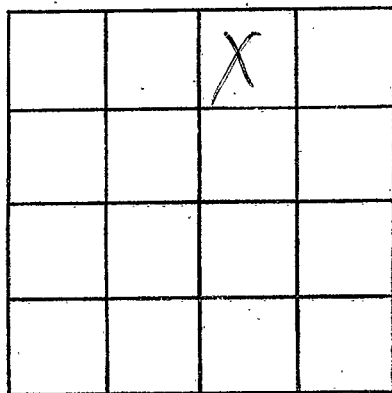

SECTION 16

Please indicate well location X.

ADDITIONAL INFORMATION

If more than one screen,  
show locations of each on sketch.