

WAYNE

N 171

7-18-74

MISSISSIPPI BOARD OF WATER COMMISSIONERS
416 North State Street
Jackson, Mississippi 39201

WATER WELL DRILLERS LOG

CODED

July 18 1974
date well completed

Porter Drilling
firm name

Wayne
county well located

LANDOWNER: Robert Bond
Owner
Waynesboro Miss
(mailing address)

description of formations encountered	from	to
sand	0	11
clay	11	15
sand	15	27
rock	27	28
blue chalk	28	42
fine cherty sand	42	57
blue chalk	57	78
rock strata	78	109
sand	109	111
rock	111	112
clay	112	126
Waynesboro sand	126	132
blue chalk	132	192
shaly blue rock	192	217

WELL LOCATION:
sec. 15 T 8 N R 7 E
S W
2 1/2 miles W of Wayneboro
(distance) (direction) (nearest town)

WELL PURPOSE: Camp & cat
(home, irrigation, municipal, industrial)

WELL COMPLETION DATA:

- (1) diameter (inches) 2"
- (2) total depth (feet) 217
- (3) static water level (feet) 38' below top of ground.
- (4) casing steel 192' (material) (depth)
2" if telescope see back.
- (5) screen none used (length) (depth to top)
- (6) pump 1 (HP) 12 (yield gpm)
elec. (type power)
- (7) electric log no (yes or no)

(organization running log)


(8) how well bottom plugged open

DRILLERS REMARKS:

RECEIVED
SEP 11 1974

If well telescopes please sketch and show depths.

GROUND LEVEL

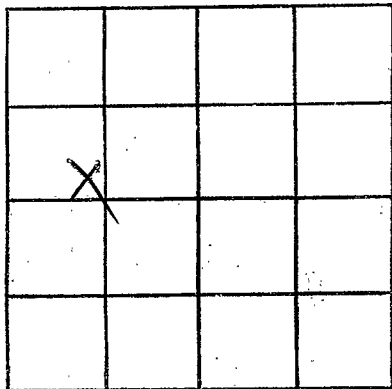

SECTION 15

Please indicate well location X.

ADDITIONAL INFORMATION

If more than one screen, show locations of each on sketch.