

WAYNE  
N 172  
9-5-74

MISSISSIPPI  
BOARD OF WATER COMMISSIONERS  
416 North State Street  
Jackson, Mississippi 39201

CODED

WATER WELL DRILLERS LOG

McILWAIN WATER WELL SERVICE WAYNE

SEPT 5, 1974  
date well completed

RT. 2 BOX 37  
WAYNESBORO, MISS. 39367

county/well located

LANDOWNER:	description of formations encountered	from	to
DAVID PALMER WAYNESBORO, MISS. (mailing address)			
WELL LOCATION:	Rock and blue clay	23	38
sec. 2 T. 8 N R. 7 E 1 miles W of WAYNESBORO (distance) (direction) (nearest town)	Rock	38	43
WELL PURPOSE: HOME (home, irrigation, municipal, industrial)	Blue clay	43	82
WELL COMPLETION DATA:	Rock	82	85
(1) diameter (inches) 4" 2"	Rock + intervals	85	105
(2) total depth (feet) 10'5"			
(3) static water level (feet) 29' below top of ground.			
(4) casing PVC (14" to 24" to 84") (material) (depth)			
(size) If telescope see back.			
(5) screen NONE (length) (depth to top)			
(size) (material)			
(6) pump 3/4 HP 7 (yield gpm) 220 AC (type power)			
(7) electric log NO (yes or no)			
(organization running log)			
(8) how well bottom plugged			


RECEIVED  
SEP 25 1974

DRILLERS REMARKS:

MISS. Bd. of WATER COMMISSIONERS

If well telescopes please sketch and show depths.

GROUND LEVEL

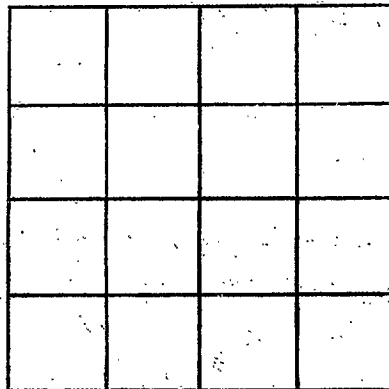

SECTION \_\_\_\_\_

Please indicate well location X.

ADDITIONAL INFORMATION

If more than one screen, show locations of each on sketch.