

WAYNE  
N 173  
10/24/74

MISSISSIPPI  
BOARD OF WATER COMMISSIONERS  
416 North State Street  
Jackson, Mississippi 39201

CODED

WATER WELL DRILLERS LOG

Oct 24 1974 date well completed  
Boyer Drilling & Log firm name  
Wayne county well located

LANDOWNER: Gratten Builders  
& Sons Co.  
P.O. Box 121 Magnolia  
(mailing address)

description of formations encountered	from	to
clay	0	11
sand	11	17
rock shales	17	32
sh. & chack	32	68
Hardburg	68	97
63' 1 1/4' deep pipe		

WELL LOCATION:  
sec. 2 T. 20 N. R. 7 E.  
1/2 miles NW of Magnolia  
(distance) (direction) (nearest town)

WELL PURPOSE: Water for building  
(home, irrigation, municipal, industrial)

- WELL COMPLETION DATA:
- (1) diameter (inches) 2'
  - (2) total depth (feet) 97
  - (3) static water level (feet) 42 below top of ground.
  - (4) casing steel 68' (material) (depth)  
2 (size) if telescope see back.
  - (5) screen none used (length) (depth to top)  
(size) (material)
  - (6) pump 1 15 (HP) (yield gpm)  
1/2 (type power)
  - (7) electric log no (yes or no)  
(organization running log)
  - (8) how well bottom plugged

CODED


RECEIVED  
DEC - 3 1974

DRILLERS REMARKS:

MISS. DD. OF WATER

If well telescopes please sketch and show depths.

GROUND LEVEL

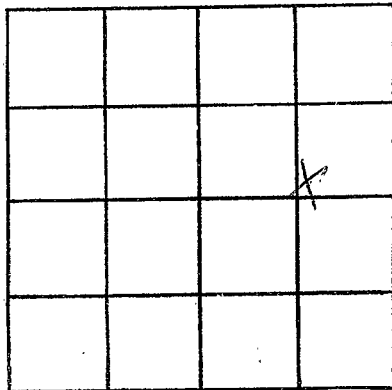

SECTION 2

Please indicate well location X.

ADDITIONAL INFORMATION

If more than one screen,  
show locations of each on sketch.