

**WAYNE**  
**N 174**  
**3-28-75**

MISSISSIPPI  
 BOARD OF WATER COMMISSIONERS  
 416 North State Street  
 Jackson, Mississippi 39201 **CODED**

**WATER WELL DRILLERS LOG**

March 28, 1975 19 McILWAIN WATER WELL SERVICE WAYNE  
 date well completed RT. from name county well located

WAYNESBORO, MISS. 39367


LANDOWNER:	description of formations encountered	from	to
<u>MR. DANIEL BEASLEY</u>	<u>Sandy Clay</u>	<u>0</u>	<u>5</u>
<u>RT 5 WAYNESBORO, MISS</u> (mailing address)	<u>Sand</u>	<u>5</u>	<u>9</u>
<b>WELL LOCATION:</b> sec. <u>8</u> T. <u>8</u> N R. <u>7</u> E <u>4</u> miles <u>W</u> of <u>W'BORO</u> (distance) (direction) (nearest town)	<u>Clay</u>	<u>9</u>	<u>25</u>
<b>WELL PURPOSE:</b> <u>HOME</u> (home, irrigation, municipal, industrial)	<u>Sand</u>	<u>25</u>	<u>28</u>
<b>WELL COMPLETION DATA:</b>	<u>Clay CODED</u>	<u>28</u>	<u>76</u>
(1) diameter (inches) <u>2"</u>	<u>Fine Sand</u>	<u>76</u>	<u>79</u>
(2) total depth (feet) <u>105'</u>	<u>Clay</u>	<u>79</u>	<u>85</u>
(3) static water level (feet) <u>55'</u> below top of ground.	<u>Sand</u>	<u>85</u>	<u>90</u>
(4) casing <u>PVC</u> <u>95'</u> (material) (depth)	<u>Clay</u>	<u>90</u>	<u>91</u>
<u>2"</u> (size) If telescope see back.	<u>Sand</u>	<u>91</u>	<u>105</u>
(5) screen <u>10'</u> <u>95'</u> (length) (depth to top)			
<u>2"</u> <u>PVC .008 slot</u> (size) (material)			
(6) pump <u>1</u> <u>9</u> (HP) (yield gpm)			
<u>220 AC</u> (type power)			
(7) electric log <u>NO</u> (yes or no)			
(organization running log)			
(8) how well bottom plugged			
<b>DRILLERS REMARKS:</b>			

**McILWAIN**  
**DRILLERS**  
**APR 14 1975**

MISS. BD. OF WATER COMMISSIONERS

If well telescopes please sketch and show depths.

GROUND LEVEL

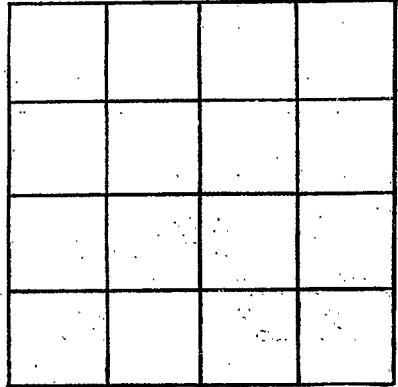

SECTION \_\_\_\_\_

Please indicate well location X.

ADDITIONAL INFORMATION

If more than one screen, show locations of each on sketch.