

Wayne
 N 176
 7-25-75

MISSISSIPPI
 BOARD OF WATER COMMISSIONERS
 416 North State Street
 Jackson, Mississippi 39201

WATER WELL DRILLERS LOG

CODED

July 25 1975 date well completed
 25 Point Drilling & Log firm name
 Wayne county well located

LANDOWNER:

Handell Moody
 Rt 3 Waynesboro
 (mailing address)

description of formations encountered

from to

red clay 0 12
 sand 12 25
 light red sand 25 35
 stopped on rock

WELL LOCATION:

sec 32 T 8 N R 7 E 13 P
 S W
 3 miles N of Clara
 (distance) (direction) (nearest town)

WELL PURPOSE:

(home, irrigation, municipal, industrial)

5' 1 1/4" 60 lb P.C.S.
 screen on end of cas
 with back wash valve
 on end

WELL COMPLETION DATA:

- (1) diameter (inches) 2"
- (2) total depth (feet) 25'
- (3) static water level (feet) 18' (below above top of ground)
- (4) casing PVC, 30' (material) (depth)
 2" if telescope see back. (size)
- (5) screen 5' 30' (length) (depth to top)
 1 1/4" 60 lb S.S. (size) (material)
- (6) pump 3/4 3 (HP) (yield gpm)
 elec (type power)
- (7) electric log no (yes or no)

(organization running log)

(8) how well bottom plugged
 back wash valve

DRILLERS REMARKS:


CODED

RECORDED
 AUG 26 1975

MISS. BD. OF WATER COMMISSIONERS

If well telescopes please sketch and show depths.

GROUND LEVEL

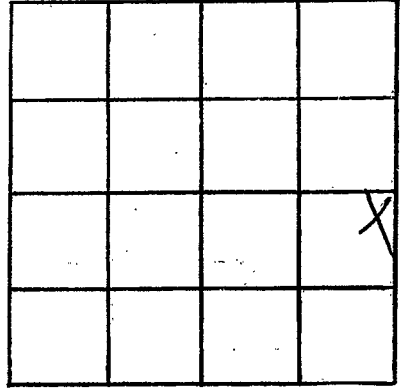

SECTION 32

Please indicate well location X.

ADDITIONAL INFORMATION

If more than one screen,
show locations of each on sketch.