

INDEXED

Wayne
N 174
8-23-75

MISSISSIPPI
BOARD OF WATER COMMISSIONERS
416 North State Street
Jackson, Mississippi 39201

WATER WELL DRILLERS LOG

Aug 23, 1975 19 McILWAIN WATER WELL SERVICE WAYNE
date well completed RT. 2, BOX 37 county well located

LANDOWNER:
MR. GEORGE O'BERRY
WAYNESBORO, Miss.
(mailing address)

WAYNESBORO, MISS. 39367
description of formations encountered

WELL LOCATION:
sec. 2 T 8 N R 7 E
1 miles W of W'BORO
(distance) (direction) (nearest town)

0 12
12 13

WELL PURPOSE: HOME
(home, irrigation, municipal, industrial)

13 25
25 45

WELL COMPLETION DATA:
(1) diameter (inches) 4" x 2"
(2) total depth (feet) 114'
(3) static water level (feet) 20 1/2' below top of ground.
(4) casing PVC 4" - 14" 2" - 9 1/2"
(material) (depth)
4" 2" if telescope see back.
(size)
(5) screen NONE
(length) (depth to top)
(size) (material)
(6) pump 3/4 10
(HP) (yield gpm)
220 AC
(type power)
(7) electric log No
(yes or no)
(organization running log)
(8) how well bottom plugged


45 95
95 114

DRILLERS REMARKS:

SEP 15 1975

If well telescopes please sketch and show depths.

GROUND LEVEL

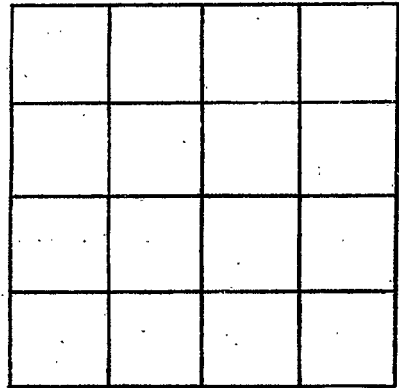

SECTION _____

Please indicate well location X.

ADDITIONAL INFORMATION

If more than one screen, show locations of each on sketch.