

MISSISSIPPI DEPARTMENT OF NATURAL RESOURCES

Bureau of Land and Water Resources

Southport Mall

P.O. Box 10631

Jackson, Mississippi 39209

WATER WELL DRILLERS LOG

CODED

WAYNE
N-178
8-29-80

Aug 29 1980 date well completed
Center Drilling & Log firm name
Wayne county well located

LANDOWNER: Tom Binkerton
Asalea Dr.
Waynesboro Miss
(mailing address)

WELL LOCATION:
sec. 23 T-8 (N) R-7 E (W)
2 miles S of Waynesboro (distance) (direction) (nearest town)

WELL PURPOSE: Farm
(home, irrigation, municipal, industrial)

WELL COMPLETION DATA:

- (1) diameter (inches) 2"
- (2) total depth (feet) 413.3'
- (3) static water level (feet) 15' below top of ground.
- (4) casing steel 414 (material) (depth)
- 2" if telescope see back. (size)
- (5) screen 19' 414 (length) (depth to top)
- 2" galv. S.S. (size) (material)
- (6) pump none 20 (HP) (yield gpm)
- flow (type power)
- (7) electric log no (yes or no)
- (organization running log)
- (8) how well bottom plugged 2' sand stake

description of formations encountered	from	to
sand	0	8
clay	8	14
sand	14	29
clay	29	44
rock strator	44	83
clay	83	163
sand	163	166
rock strator	166	206
white clay + rock	206	240
clay	240	308
flint rock		308
clay	308	327
flint rock		327
clay	327	386
rock strator	386	411
clay sand	411	420
sand some clay	420	432
rock	432	433
sand	433	438
stip. on rock		

DRILLERS REMARKS:


DEPT. OF NATURAL RESOURCES
BUREAU OF LAND & WATER RESOURCES

SEP 24 1980

RECEIVED

If well telescopes please sketch and show depths.

GROUND LEVEL

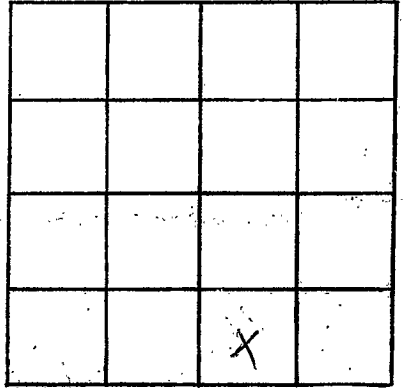

SECTION 23

Please indicate well location X.

ADDITIONAL INFORMATION

If more than one screen,
show locations of each on sketch.