

MISSISSIPPI DEPARTMENT OF NATURAL RESOURCES

Bureau of Land and Water Resources

Southport Mall

P.O. Box 10631

Jackson, Mississippi 39209

WATER WELL DRILLERS LOG

CODED

WAYNE
N 180
9-17-81

Sept 17 date well completed 21 Porter Drilling & Exp firm name Wayne county well located

LANDOWNER: Ben Laws
Waynesboro, Miss

(mailing address)

WELL LOCATION:
sec. 6 T 8 N R 6 E
in Waynesboro
(distance) miles (direction) of (nearest town)

WELL PURPOSE: Home
(home, irrigation, municipal, industrial)

- WELL COMPLETION DATA:
- (1) diameter (inches) 4"
 - (2) total depth (feet) 174'
 - (3) static water level (feet) 90' below above top of ground.
 - (4) casing steel, 140'
(material) (depth)
4"
(size) If telescope see back.
 - (5) screen none used
(length) (depth to top)

(size) (material)
 - (6) pump 2 33
(HP) (yield gpm)

(type power)
 - (7) electric log no
(yes or no)


(organization running log)
 - (8) how well bottom plugged open

description of formations encountered	from	to
clay	0	5
sand & gravel	5	29
clay	29	59
rock strata	59	74
sand	74	77
rock	77	93
clay	93	100
sand	100	108
clay	108	139
limestone rock	139	174

DEPT. OF NATURAL RESOURCES
BUREAU OF LAND & WATER RESOURCES

SEP 18 1981


RECEIVED

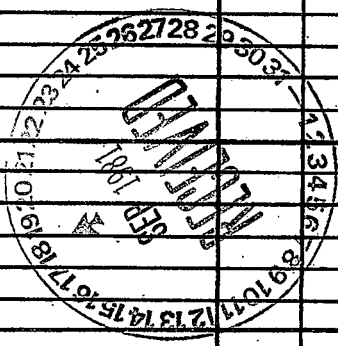

DRILLERS REMARKS:

If well telescopes please sketch and show depths.

GROUND LEVEL

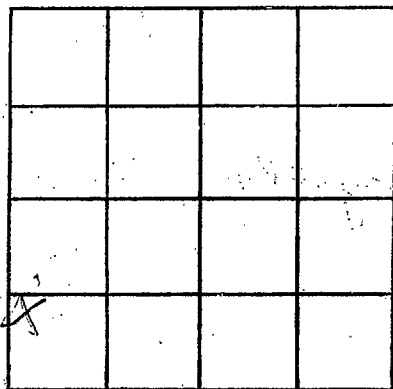

SECTION 6

Please indicate well location X.

ADDITIONAL INFORMATION

If more than one screen,
show locations of each on sketch.