

MISSISSIPPI DEPARTMENT OF NATURAL RESOURCES

Bureau of Land and Water Resources

Southport Mall

P.O. Box 10631

Jackson, Mississippi 39209

CODED

WATER WELL DRILLERS LOG

Griner Drilling Service

Wayne

WAYNE  
N 181

10-20-84

date well completed

firm name

county well located

LANDOWNER:

Exxon Company U.S.A.  
P.O. Box 51208  
New Orleans, La. 70905  
(mailing address)

description of formations encountered

from to

clay, rock 0 40

clay 40 63

clay & rocks 63 609

clay, sand 609 630

clay, shell, mostly sand 630 693

WELL LOCATION: 3200'S + 1000'E

sec. 17 T. 9 N R. 7 E of NW/4

No. 3 N. M. Luck East Yellow Ck. (distance) (nearest town)

WELL PURPOSE: oilfield supply (home, irrigation, municipal, industrial)

WELL COMPLETION DATA:

(1) diameter (inches) 3"

(2) total depth (feet) 693'

(3) static water level (feet) 50' below top of ground.

(4) casing steel, 693' (material) (depth)

3" if telescope see back. (size)

(5) screen 63' 630' (length) (depth to top)

3" perforated (size) (material)

(6) pump 80-85 (HP) (yield gpm)

AC (type power)

(7) electric log (yes or no)

(organization running log)

(8) how well bottom plugged orange peel

CODED

Water Well No. 1

DEPT. OF NATURAL RESOURCES BUREAU OF LAND & WATER RESOURCES


NOV 14 1984

RECEIVED

DRILLERS REMARKS:

If well telescopes please  
sketch and show depths.

GROUND LEVEL

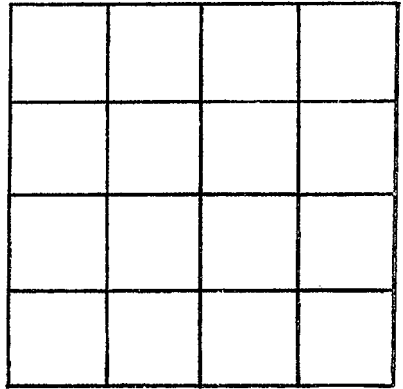

SECTION \_\_\_\_\_

Please indicate well location X.

ADDITIONAL INFORMATION

If more than one screen,  
show locations of each on sketch.