

MISSISSIPPI DEPARTMENT OF NATURAL RESOURCES

Bureau of Land and Water Resources

Southport Mall

P.O. Box 10631

Jackson, Mississippi 39209

WATER WELL DRILLERS LOG

CODED

WAYNE
N182

10-20-84 date well completed Griner Drilling Service, Inc. firm name Wayne county well located

LANDOWNER:	description of formations encountered	from	to
EXXON Company U.S.A. P.O. BOX 51208 Lafayette, La. 70160 (mailing address)	clay, rock	0	40
	clay	40	63
WELL LOCATION: 3200'S x 1000'E sec. 17 T. 9 N R. 7 E of No. 3 M.M. East Yellow Creek Field Roebuck et al (distance) (direction)	clay, rock	63	609
	clay, sand, shell	609	630
WELL PURPOSE: oilfield supply (home, irrigation, municipal, industrial)	clay, sand, shell	630	693
	clay	693	714
WELL COMPLETION DATA:			
(1) diameter (inches) 3'			
(2) total depth (feet) 714'			
(3) static water level (feet) 70' below top of ground.			
(4) casing steel 714' (material) (depth)			
3" (size) if telescope see back.			
(5) screen 42' 672' (length) (depth to top)			
3" perforated (size) (material)			
(6) pump - 80 (HP) (yield gpm)			
AC (type power)			
(7) electric log (yes or no)			
(organization running log)			
(8) how well bottom plugged orange peel			
DRILLERS REMARKS:			

CODED


DEPT. OF NATURAL RESOURCES
BUREAU OF LAND & WATER RESOURCES

NOV 14 1984

RECEIVED

If well telescopes please
sketch and show depths.

GROUND LEVEL

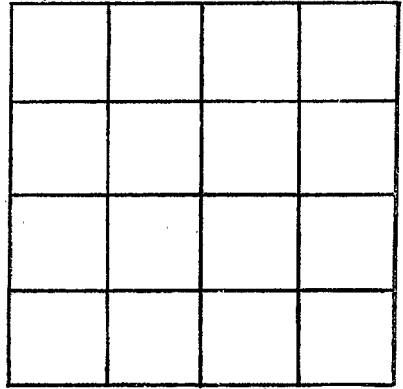

SECTION _____

Please indicate well location X.

ADDITIONAL INFORMATION

If more than one screen,
show locations of each on sketch.