

MISSISSIPPI DEPARTMENT OF NATURAL RESOURCES

Bureau of Land and Water Resources

Southport Mall

P.O. Box 10631

Jackson, Mississippi 39209

WATER WELL DRILLERS LOG

N 184
Wayne

May 1
1985

85 Porter Drilling & Supply

Itasca
county well located

date well completed

firm name

county well located

LANDOWNER: Jimmy Stotley
Bl 3 R 9 1310 A
Itasca, Ms.
(mailing address)

description of formations encountered

from to

WELL LOCATION:
sec. 12 T-8 N R-7
1/2 miles (distance) of 7 (direction) of Itasca (nearest town)

sand	0	14
clay	14	29
rock strata	29	38
clay	38	55
sand strata	55	66
clay	66	75
med. firm sand	75	87
stagnant on top		
sand & lignite		

WELL PURPOSE:
(home, irrigation, municipal, industrial)

WELL COMPLETION DATA:

- (1) diameter (inches) 2
- (2) total depth (feet) 87'
- (3) static water level (feet) 16' below above top of ground
- (4) casing (material) PVC (depth) 82'
(size) if telescope see back. 5'
- (5) screen (length) 2" (depth to top) 82' P.V.C.
(size) (material) 1" 1/2
- (6) pump elec. (HP) (yield gpm)
- (7) electric log no (yes or no)

27' 1" P.V.C. down pipe

(organization running log)

(8) how well bottom plugged


DRILLERS REMARKS:

RECEIVED
MAY - 6 1985

Department of Natural Resources
Bureau of Land & Water Resources

If well telescopes please sketch and show depths.

GROUND LEVEL

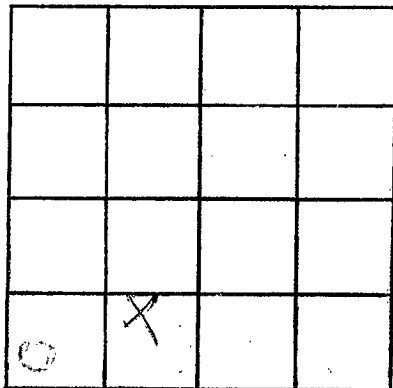

SECTION 24

Please indicate well location X.

ADDITIONAL INFORMATION

If more than one screen,
show locations of each on sketch.