

MISSISSIPPI DEPARTMENT OF NATURAL RESOURCES

Bureau of Land and Water Resources

Southport Mall

P.O. Box 10631

Jackson, Mississippi 39209

WATER WELL DRILLERS LOG **CODED**

Wayne
N 186

Sept 24 1982 Porter Drilling & Log Wayne
 (date well/completed) (firm name) (county well located)

LANDOWNER: Valley Bros
P.O. Box 335
Waynesboro Miss
 (mailing address)

WELL LOCATION:
 sec. 11 T 8 N R 7 E
5 miles W of Waynesboro
 (distance) (direction) (nearest town)

WELL PURPOSE: industrial
 (home, irrigation, municipal, industrial)

WELL COMPLETION DATA:

(1) diameter (inches) 4"
 (2) total depth (feet) 140'
 (3) static water level (feet) 24' (below/above top of ground.)
 (4) casing steel (material) (depth) 4" (size) If telescope see back.
 (5) screen none used (length) (depth to top) (size) (material)
 (6) pump 2 (HP) 3.3 (yield gpm) elec (type power)
 (7) electric log (yes or no) (organization running log)
 (8) how well bottom plugged open

description of formations encountered	from	to
Clay	0	6
clay	6	14
Clay COLEMAN		26
rock strata	26	47
Clay	47	98
limestone rock	98	140
34' 1/2" dia pipe		
SOUTH SIDE of Hwy 84 East of bridge about 1-2 miles		

DRILLERS REMARKS:


DEPT. OF NATURAL RESOURCES
 BUREAU OF LAND & WATER RESOURCES

OCT 25 1982

RECEIVED

If well telescopes please sketch and show depths.

GROUND LEVEL

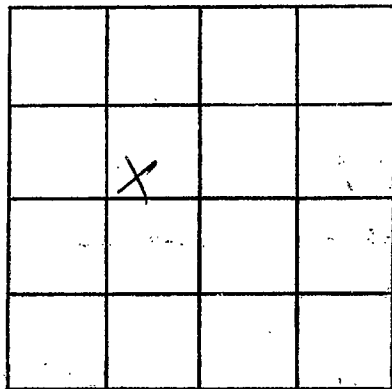

SECTION 11

Please indicate well location X.

ADDITIONAL INFORMATION

If more than one screen, show locations of each on sketch.