

MISSISSIPPI DEPARTMENT OF NATURAL RESOURCES

Bureau of Land and Water Resources

Southport Mall

P.O. Box 10631

Jackson, Mississippi 39209

WATER WELL DRILLERS LOG

CODED

WAYNE
N 187

8-15-1985 GRINER DRILLING SERVICE WAYNE
date well completed firm name county well located

LANDOWNER: T. K. STAMLEY
WAYNESBORO, MISS.
(mailing address)

Description of formations encountered	from	to
CLAY, sawdust & sand	0	10
SAND	10	20
CLAY, ROCKS & SAND	20	27.3

WELL LOCATION: N 24, SW 1/4
sec. 11 T. 8 N S R. 7 E W
(distance) miles (direction) of (nearest town)

WELL PURPOSE:
(home, irrigation, municipal, industrial)

WELL COMPLETION DATA:

(1) diameter (inches) 4"

(2) total depth (feet) 90

(3) static water level (feet) 35 below above top of ground.

(4) casing PVC (material), 90 (depth), 4" (size) If telescope see back.

(5) screen (length) (depth to top) (size) (material)

(6) pump 5 (HP), 37 (yield gpm)

ELECT. (type power)

(7) electric log NO (yes or no)
P (organization running log)

(8) how well bottom plugged Opta ended

CODED

RECEIVED


JAN 12 1985

Department of Natural Resources
Bureau of Land & Water Resources

DRILLERS REMARKS:

If well telescopes please
sketch and show depths.

GROUND LEVEL

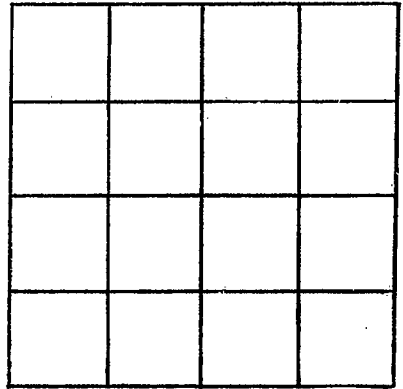

SECTION _____

Please indicate well location X.

ADDITIONAL INFORMATION

If more than one screen,
show locations of each on sketch.