

# State Well Report

## Part 1 - Driller's Log

Mississippi Department of Environmental Quality  
Office of Land and Water Resources  
P.O. Box 2309  
Jackson, MS 39225  
(601)961- 5210  
(601)961- 5228 (fax)

County: Wayne  
Permit #: 5496  
Driller: EARL MOSELEY  
Date drilling completed: 5-22-16

For Office Use Only:  
Aquifer: \_\_\_\_\_  
Well #: N 206  
L. S. Elevation: \_\_\_\_\_  
E-log #: \_\_\_\_\_

**State Law requires that this report be prepared by the license holder responsible for the work and filed with the Department at the above address within 30 days of completion of drilling of the well or borehole.**

Information on Well Owner (Landowner if borehole is not for a water well)	Well or Borehole Location
Owner Name: <u>RAY LUTON</u>	Latitude: <u>31° 41' 14"</u> Longitude: <u>88° 41' 24"</u>
Mailing Address: <u>711 STATION ST.</u>	Method of Lat/Long (circle one): Conventional Survey,
<u>WAYNESBOND MS 39367</u>	USGS quad, Hand-held GPS, Survey-grade GPS
City State Zip Code	<u>NE 1/4 SE 1/4 Sec 4 Twn 8N Rng 7W</u>
Telephone No. ( )	Distance Direction Nearest Town
	<u>2 Miles WEST of WAYNESBOND</u>

**Well / Borehole Data**

Date drilling started: 5-22-16 Date drilling completed: 5-22-16 Hole depth: 255 Hole diameter: 4"

Location of the source of any surface water used for drilling: 837 COUNTY LAKE DRINKIN RD.

Method of dosing and volume of Chlorine used in drilling and development: 4 OZ HTH PER 1000 GALL

Logs run (circle all applicable): No log run Electric Gamma Ray Density Sonic Neutron Other: \_\_\_\_\_

Name of organization running log(s): \_\_\_\_\_

Purpose of borehole (check one): Water Well  Geotechnical/Geological Investigation \_\_\_\_\_ Ground Source Heat Pump \_\_\_\_\_

Seismic Survey \_\_\_\_\_ Other (describe) \_\_\_\_\_

**If drilling is not related to water well construction, skip the remainder of this block**

Purpose of Well (check one): Home  Industrial \_\_\_\_\_ Public Supply \_\_\_\_\_ Irrigation  Fish Culture \_\_\_\_\_ Other: \_\_\_\_\_

If a flowing well, method of flow regulation: Valve \_\_\_\_\_ Other (describe) \_\_\_\_\_

Static Water Level: 143 feet above or below (circle one) land surface Date measured: 5-22-16

Method of Measurement (circle one) steel tape electric tape air line other: \_\_\_\_\_

Well depth: 255 Well grouted to a depth of 10 feet Type of grout (circle one): Neat Cement Bentonite Mix

Casing length: 213 feet Casing diameter: 4" inches Type of casing: PVC

Screen length: OPEN feet Screen diameter: 4" inches Type of screen: PVC

Screen slot size: N/A inches Setting depth: From \_\_\_\_\_ feet to \_\_\_\_\_ feet

Type of completion (circle all applicable): Gravel packed Underreamed Telescoped Open hole Natural Development


Other (describe): \_\_\_\_\_

Top of lap pipe or reduction in casing: \_\_\_\_\_ feet. **If telescoped or more than one screen, describe on next page**

Received  
Form: OLWR-SWR-1A (04/06)  
JUL 07 2016  
By OLWR

The sketch below only required for water wells

If well telescopes, show depths on sketch.

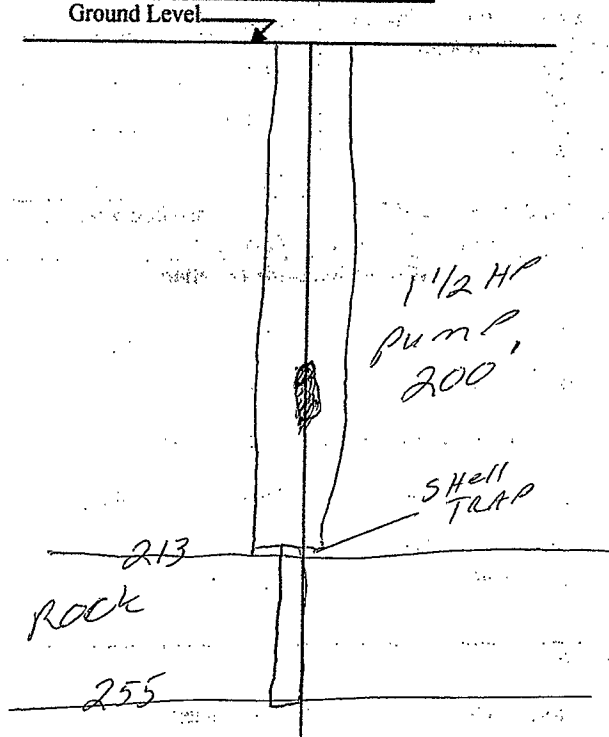


Description of formations encountered must be provided for all wells and boreholes, unless specifically exempted by regulations

Description of Formations Encountered	From (depth)	To (depth)
TOP SOIL	Ground Level	2
BROWN SAND	2	5
WHITE SAND	5	20
PEA GRAVEL	20	22
GRAY PINK CLAY	22	38
MED. WHITE SAND	38	72
PINK CLAY	82	88
FINE SAND	88	110
BLUE CLAY	110	118
SAND	118	124
BLUE CLAY & R	124	131
ROCK & CLAY	131	144
CLAY	144	146
ROCK	146	147
CLAY	147	148
ROCK	148	149
Lime stone & shell	149	160
ROCK	160	167
Blue clay	167	202
SAND	202	204
Blue clay	204	213
Honey comb Rock	213	255

If more than one screen, show location of each on sketch

Sketch the property layout and include the following: 1) the well location; 2) any permanent structures on the property that may aid in locating the well; 3) any roads, power lines, or other items that may aid in locating the property and the well; 4) a north arrow.

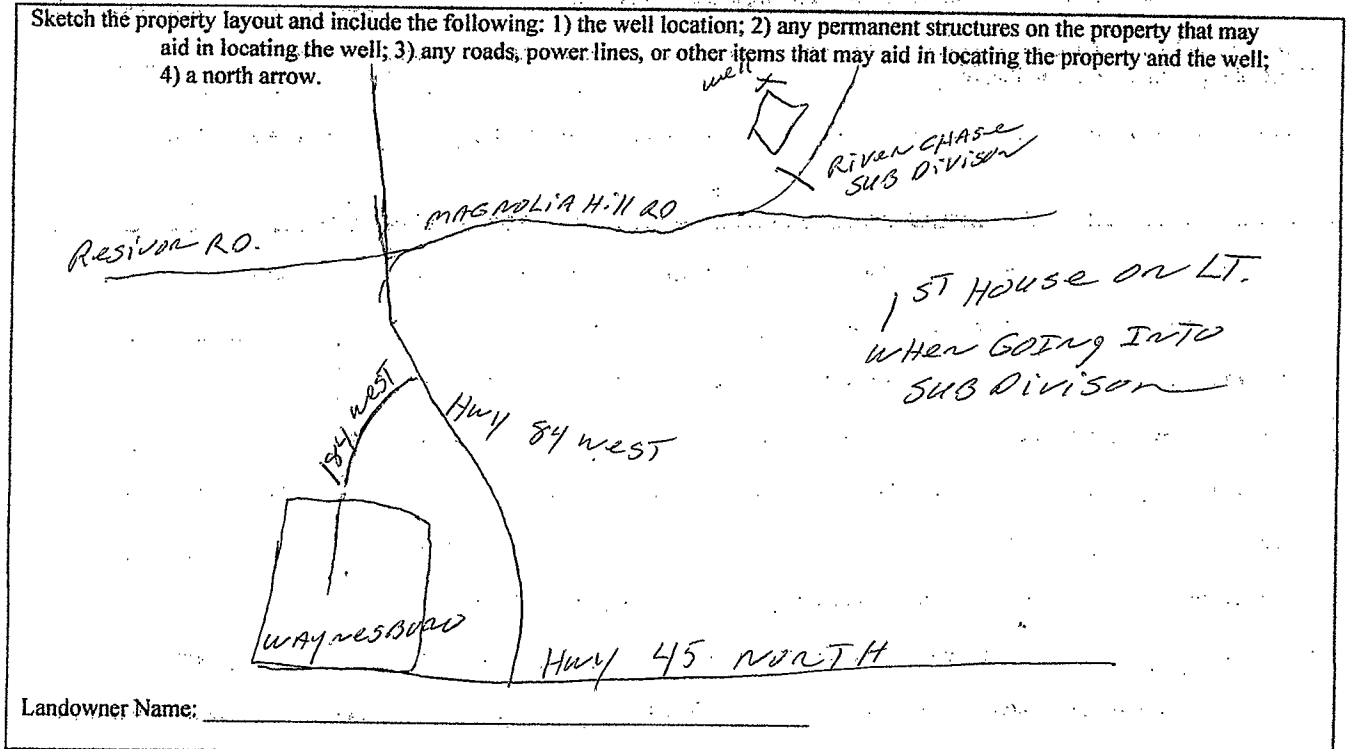

Form: OLWR-SWR-1A (04/08)

I certify that the well/borehole was drilled, constructed, and completed in accordance with all applicable requirements of the Mississippi Department of Environmental Quality and the Mississippi Department of Health regulations, if applicable, and state laws.

EARL MOSELEY 5496  
Print Name of Responsible Licensee and License No.

Date

Earl Moseley  
Signature of Licensee

# STATE WELL REPORT

## Part 2

**Pump Installer's Completion Report**  
 Mississippi Department of Environmental Quality  
 Office of Land and Water Resources  
 P.O. Box 2309  
 Jackson, MS 39225  
 (601)961-5210  
 (601)961-5228 (fax)

County: Wayne  
 Permit #: 5496  
 Driller: EARL MOSELEY  
 Date completed: 5-20-16  
*Copy information from block on Part 1*

**For Office Use Only:**

Aquifer: \_\_\_\_\_  
 Well #: N206  
 Elevation: \_\_\_\_\_

*This part of the report must be completed by a licensed water well contractor or a licensed pump installer. A copy of Part 1 of the report must be attached and both parts filed with the Department at the above address within 30 days of well completion.*

Well Owner Information	Well Location
Owner Name: <u>RAY LOFTON</u>	Latitude: <u>31-41-14</u> Longitude: <u>88-41-24</u>
Mailing Address: <u>711 STATION ST</u>	Method of Lat/Long (check one): Conventional Survey _____
<u>Waynesboro MS 39367</u>	USGS quad _____ Hand-held GPS <input checked="" type="checkbox"/> Survey-grade GPS _____
City State Zip Code	<u>NE 1/4 SE 1/4 Sec 4 T 8N R 7W</u>
Telephone No. ( ) _____	Distance Direction Nearest Town
	<u>2</u> Miles <u>west</u> of <u>Waynesboro</u>

Pump Type Circle one	Power Type Circle one
Air Lift Jet <input checked="" type="radio"/> <u>Submersible</u>	Diesel Engine Gasoline Engine Natural Gas
Bucket Piston Turbine	<input checked="" type="radio"/> <u>Electric Motor</u> Hand Tractor PTO
Centrifugal Rotary Flowing Well	Windmill Other (specify): _____
Other (specify): _____	Horse Power Rating of Motor: <u>1 1/2 HP</u>
Date Pump Installed: <u>5-22-16</u>	Setting Depth: <u>200'</u> feet
Rated Pump Capacity: <u>19</u> Gallons Per Minute	Number of Stages: _____

Pump Test Data	Method of Measuring Water Level Circle one
Date Well Tested: <u>5-22-16</u>	Air Line Electric Measuring Line <input checked="" type="radio"/> <u>Steel Tape</u>
Static Water Level (A): <u>143</u> Feet Below Land Surface	Other (specify): _____
Pumping Water Level (B): <u>255</u> feet Below Land Surface	For flowing well, measured shut in head: _____ feet
Drawdown [(B)-(A)]: <u>112</u> Feet Below Land Surface	Well yielded _____ GPM with a drawdown of _____ feet after _____ hours of pumping
Test Pumping Rate: <u>27</u> Gallons Per Minute	
Duration of Pump Test (minimum 4 hours): <u>4</u> hours	

I HEREBY CERTIFY that the above statements are true to the best of my knowledge.

EARL MOSELEY 5496 Earl Moseley  
 Print Name of Pump Installer and License No. (if applicable) Signature of Pump Installer

**Received**  
 JUL 07 2016  
 Form: OLWR-SWR-1B (04/08)  
 BY OLWR

The first part of the document discusses the importance of maintaining accurate records of all transactions. It emphasizes that every entry should be supported by a valid receipt or invoice. This not only helps in tracking expenses but also ensures compliance with tax regulations.

In the second section, the author outlines the various methods used for data collection and analysis. These include surveys, interviews, and focus groups. Each method has its own strengths and weaknesses, and the choice depends on the specific needs of the study.

The third section provides a detailed overview of the research methodology. It describes the sampling process, the data collection instruments used, and the statistical techniques applied to analyze the results. The goal is to ensure that the findings are reliable and valid.

Finally, the document concludes with a summary of the key findings and their implications. It highlights the main trends observed in the data and offers practical recommendations based on the research results. The author also acknowledges the limitations of the study and suggests areas for future research.