

WAYNE
N 8500

Date: Sept., 1962, Driller: Peepers & Rutledge County Wayne
9-62 (Name)

(1) Owner of Land: Hubert D. Hunter
(Name)
Rt. 3 Box 473 Waynesboro
(Address)

(2) Location: 1/4, 1/4, Sec. 2 T8R3
4 miles West of Waynesboro
(distance) (direction) (Nearest Town)

(3) Topography: Hilly
(Hilly) (Flat) (Level)

(4) Purpose of Well: Domestic
(Domestic Irrigation
Municipal, Industrial, Other)

Description & Color of Materials Sand, Clay, Red Clay, Shell, etc.	Thick- ness Feet	Depth Feet
Tap bored to yellow		
sandy clay + sand streak	21	21
yellow sandy clay	21	42
blue clay	11	53
Brown & red gumbo	20	73
Blue clay	10	83
Rock (limestone)	1	84
white sand	8	92

Information upon completion of well:

(1) Diameter 2 inches.

(2) Total Depth 92 feet.

(3) Water Level 71 feet below top of ground.

(4) Cased to 86', Size 2"

(5) Screen: Size 2", Length 6'


(6) Were any formations sealed against pollution?
_____ yes, _____ no.

Cannot locate
Rn

If YES depth of formation _____

Why _____

Drillers Remarks: _____

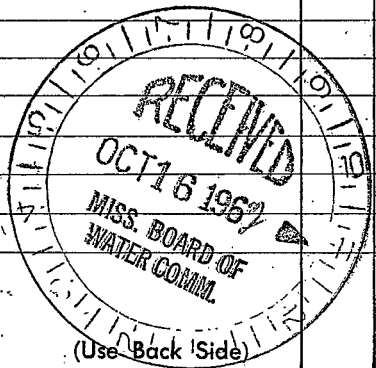

Well No.

