

N 3001

9-62

WATER WELL DRILLERS LOG

Date: Sept., 19 62, Driller: Poyant & Outley County Wayne

(Name)

(1) Owner of Land: Marie B. Williams (Name)

Rt 3 Waynesboro Miss (Address)

(2) Location: 1/4, 1/4, Sec. 2 T 7 R 7

4 miles W of Waynesboro (distance) (direction) (Nearest Town)

(3) Topography: Hilly (Hilly) (Flat) (Level)

(4) Purpose of Well: Domestic (Domestic Irrigation, Municipal, Industrial, Other)

Information upon completion of well:

(1) Diameter 2 inches.

(2) Total Depth 172 feet.

(3) Water Level 85 feet below top of ground.

(4) Cased to 108', Size 2"

(5) Screen: Size 2", Length 6'

(6) Were any formations sealed against pollution? yes, no.

If YES depth of formation

Why

Drillers Remarks:

Description & Color of Materials Sand, Clay, Red Clay; Shell, etc.

Thick-ness Feet

Depth Feet

Top soil to yellow

Sandy clay

Blue sand

~~Light yellow~~

Rock

Yellow S-L

Gray shale

Yellow S-L

48 48

42 90

1 91


2 93

33 126

46 172

0

Cannot locate

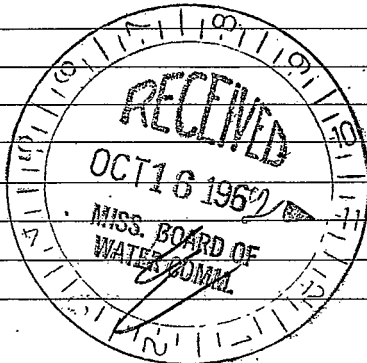

Well No.

(Use Back Side)

