

Wayne
 No. 2000
 9/20/75

MISSISSIPPI
 BOARD OF WATER COMMISSIONERS
 416 North State Street
 Jackson, Mississippi 39201

WATER WELL DRILLERS LOG

Sept 20 1975 Port Dillingham Dr. Wayne
 date well completed firm name county well located

LANDOWNER: Jimmy Bowen
 1305 Klama Dr.
 Waynesboro Miss.
 (mailing address)

WELL LOCATION:
 sec. 8 T. 3 N R. 7 E 13P
 S W W
 (distance) (direction) (nearest town)

WELL PURPOSE: farm
 (home, irrigation, municipal, industrial)

WELL COMPLETION DATA:

(1) diameter (inches) 4"
 (2) total depth (feet) 261
 (3) static water level (feet) 93 below top of ground.
 (4) casing steel, 235' (material) (depth)
 4' If telescope see back. (size)
 (5) screen none used (length) (depth to top)
 (size) (material)
 (6) pump 1/2 30 (HP) (yield gpm)
 elec. (type power)
 (7) electric log no (yes or no)
 (organization running log)
 (8) how well bottom plugged open

description of formations encountered	from	to
red clay	0	35
sand & clay	35	55
sand & clay	55	65
clay	65	120
red strata	120	160
clay	160	186
sand	186	190
clay	190	192
sand	192	202
clay	202	235
theobryng rock	235	261

147' 1" deep pipe


INDEXED
 DEC 4 1975

DRILLERS REMARKS:

MISS. BD. OF WATER COMMISSIONERS

If well telescopes please sketch and show depths.

GROUND LEVEL

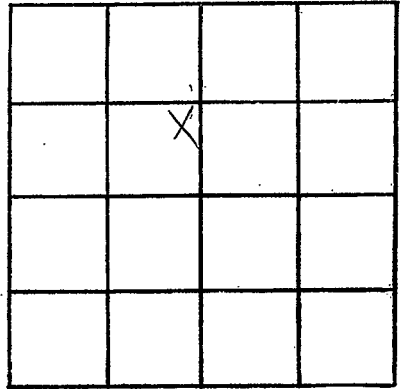

SECTION 8

Please indicate well location X.

ADDITIONAL INFORMATION

If more than one screen, show locations of each on sketch.