

WAYNE
 N 2003
 12-10-75

MISSISSIPPI
 BOARD OF WATER COMMISSIONERS
 416 North State Street
 Jackson, Mississippi 39201

WATER WELL DRILLERS LOG

McILWAIN WATER WELL SERVICE

Wayne

DEC 10, 1975
 date well completed


19

RI firm name BOX 37

county well located

WAYNESBORO MISS 39367

LANDOWNER:	description of formations encountered	from	to
MR. E. S. ROBERTS			
Waynesboro, Miss. (mailing address)	Brown Clay	17	21
WELL LOCATION: sec. 10 T 8 N R 7 E 1 miles W of W'BORO (distance) (direction) (nearest town)	Sand	21	27
	Blue Clay	27	31
WELL PURPOSE: HOME (home, irrigation, municipal, industrial)	Rock & Limy Clay	31	55
WELL COMPLETION DATA:	Blue Clay	55	97
(1) diameter (inches) 4" X 2"	Honey Comb		
(2) total depth (feet) 116'	Rock	97	116
(3) static water level (feet) 22' below top of ground.			
(4) casing 4" - 28' 2" - 102' (material) (depth)			
4+2 (size) if telescope see back.			
(5) screen NONE (length) (depth to top)			
(size) (material)			
(6) pump 3/4 (HP) 8 (material) (yield gpm)			
110 AC (type power)			
(7) electric log NO (yes or no)			
(organization running log)			
(8) how well bottom plugged			

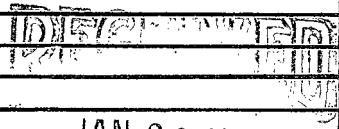


JAN 20 1976

DRILLERS REMARKS:

If well telescopes please sketch and show depths.

GROUND LEVEL

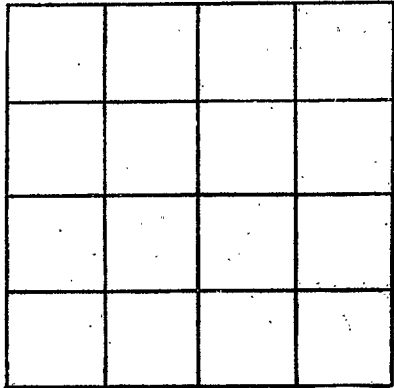

SECTION _____

Please indicate well location X.

ADDITIONAL INFORMATION

A series of horizontal lines for entering additional information.

If more than one screen, show locations of each on sketch.