

Wayne
N 2004
12-20-75

MISSISSIPPI
 BOARD OF WATER COMMISSIONERS
 416 North State Street
 Jackson, Mississippi 39201

WATER WELL DRILLERS LOG

Dec 20 1975 P. D. D. Drilling Co. Wayne
 date well completed firm name county well located

LANDOWNER: Mrs. Janner
West 14.01 Janner St
Waynesboro Miss.
 (mailing address)

WELL LOCATION:
 sec. 6 T. 9 N. R. 7 E.
1.4 miles west of Waynesboro
 (distance) (direction) (nearest town)

WELL PURPOSE: Home
 (home, irrigation, municipal, industrial)

- WELL COMPLETION DATA:
- (1) diameter (inches) 2"
 - (2) total depth (feet) 121'
 - (3) static water level (feet) 75' (below top of ground)
 - (4) casing PVC, 116'
 (material) (depth)
2" if telescope see back.
 (size)
 - (5) screen 5', 116'
 (length) (depth to top)
1 1/2", bed of SS
 (size) (material)
 - (6) pump 1, 5
 (HP) (yield gpm)
elec.
 (type power)
 - (7) electric log no
 (yes or no)


description of formations encountered	from	to
rest clay	0	15
silty sand with clay	15	100
med coarse clay sand	100	121
2' liquid water shell in sand		
5' 1" PVC casing		
5' 1 1/2' bed of SS		
at end of casing well back water level at end of well log above		

DRILLERS REMARKS:

RECEIVED
 FEB 18 1976

If well telescopes please sketch and show depths.

GROUND LEVEL

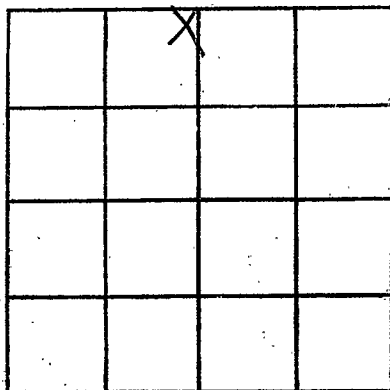

SECTION 6

Please indicate well location X.

ADDITIONAL INFORMATION

If more than one screen,
show locations of each on sketch.