

Wayne
N 2005
3/13/76

13P

MISSISSIPPI
BOARD OF WATER COMMISSIONERS
416 North State Street
Jackson, Mississippi 39201

WATER WELL DRILLERS LOG

MARCH 13, 1976
date well completed

MGILWAIN WATER WELL SERVICE WAYNE

RT. # 10 BOX 37

county well located

WAYNESBORO, MISS. 39367

LANDOWNER:

RUSSELL CLARK

WAYNESBORO, MISS.
(mailing address)

description of formations encountered

from

to

Red Clay

0

5

Sand

5

32

WELL LOCATION:

sec. 25 T 8 N R 7 E W BORO
3 miles S of W BORO
(distance) (direction) (nearest town)

Blue Clay, some Rock

32

42

WELL PURPOSE: Home
(home, irrigation, municipal, industrial)

Timy Rock

42

46

WELL COMPLETION DATA:

- (1) diameter (inches) 2"
- (2) total depth (feet) 87'
- (3) static water level (feet) 12 1/2' below top of ground.
- (4) casing PVC 83' (material) (depth)
2" (size) If telescope see back.
- (5) screen 4' 83' (length) (depth to top)
2" PVC #008 (size) (material)
- (6) pump 2 (HP) 12 (yield gpm)
220 AC (type power)
- (7) electric log no (yes or no)

Blue Clay

46

78

Rock

78

80

Med Sand


80

87

(organization running log)

(8) how well bottom plugged


DRILLERS REMARKS:

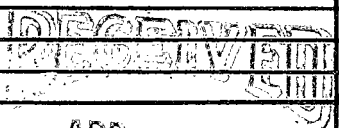

APR 20 1976

If well telescopes please sketch and show depths.

GROUND LEVEL

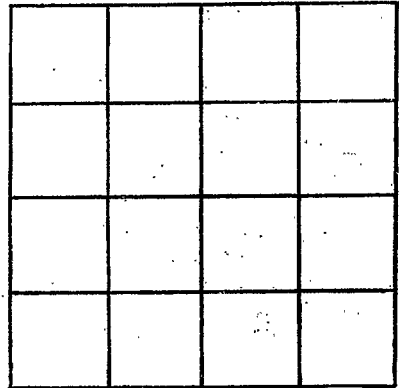

SECTION _____

Please indicate well location X.

ADDITIONAL INFORMATION

If more than one screen, show locations of each on sketch.