

Wayne
N 2000
March 18, 1976

MISSISSIPPI
BOARD OF WATER COMMISSIONERS
416 North State Street
Jackson, Mississippi 39201

WATER WELL DRILLERS LOG

March 18 1976 Bohler Drilling Wayne
date well completed firm name county well located

LANDOWNER: Henneth Kelley
Box 32 Hammond
(mailing address)

WELL LOCATION:
sec. 2 T 2 (N) R 7 (E) S (W)
3 miles W of Wetumpka
(distance) (direction) (nearest town)

WELL PURPOSE: Home
(home, irrigation, municipal, industrial)

- WELL COMPLETION DATA:
- (1) diameter (inches) 2"
 - (2) total depth (feet) 7'
 - (3) static water level (feet) 34' (below top of ground)
 - (4) casing PVC, 66'
(material) (depth)
2" If telescope see back.
(size)
 - (5) screen 5', 66'
(length) (depth to top)
1/2", 60 L.S.S.
(size) (material)
 - (6) pump 1, 7
(HP) (yield gpm)
elec
(type power)
 - (7) electric log no
(yes or no)
- (organization running log)
- (8) how well bottom plugged
back wash valve


description of formations encountered	from	to
<u>blue sand</u>	<u>0</u>	<u>2.5</u>
<u>blue sand</u>	<u>2.5</u>	<u>3.5</u>
<u>red sand</u>	<u>3.5</u>	<u>6.2</u>
<u>red sand</u>	<u>6.2</u>	<u>7'</u>
<u>5' to 6" L.S.S. casing</u>		
<u>on end of casing with back wash valve on</u>		
<u>end of well string</u>		
<u>above</u>		
<u>42' 1" P.V.C. pipe</u>		
<u>pipe</u>		

APR 19 1976
MISS. Bd. OF WATER COMM.

DRILLERS REMARKS:

If well telescopes please sketch and show depths.

GROUND LEVEL

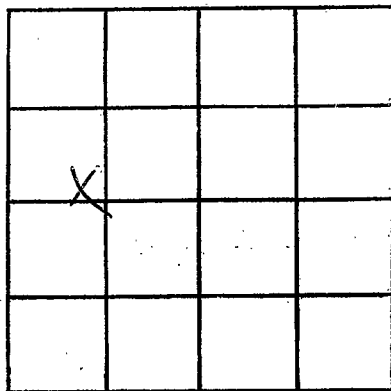

SECTION 8

Please indicate well location X.

ADDITIONAL INFORMATION

If more than one screen,
show locations of each on sketch.