

Wayne
N 2007
3-22-76

MISSISSIPPI
 BOARD OF WATER COMMISSIONERS
 416 North State Street
 Jackson, Mississippi 39201

WATER WELL DRILLERS LOG

McILWAIN WATER WELL SERVICE Wayne

MARCH 22, 1976 19
 date well completed

BOX 37
 firm name
WAYNESBORO MISS 39367

county well located


LANDOWNER:
ALBERT RAE JONES
ROUTE 5 Box 423 W'BORO
 (mailing address)

description of formations encountered	from	to
<u>Red Clay</u>	<u>0</u>	<u>8</u>
<u>Red Sand</u>	<u>8</u>	<u>20</u>
<u>Med Sand</u>	<u>20</u>	<u>38</u>

WELL LOCATION:
 sec. 30 T 8 N R. 7
6 miles SW of W'BORO
 (distance) (direction) (nearest town)

WELL PURPOSE: HOME
 (home, irrigation, municipal, industrial)

- WELL COMPLETION DATA:
- (1) diameter (inches) 2"
 - (2) total depth (feet) 38'
 - (3) static water level (feet) 21' below top of ground.
 - (4) casing PVC 34'
 (material) (depth)
2" if telescope see back.
 (size)
 - (5) screen 4' 34'
 (length) (depth to top)
2" PVC .008
 (size) (material)
 - (6) pump 1 7.5
 (HP) (yield gpm)
220 AC
 (type power)
 - (7) electric log no
 (yes or no)
- (organization running log)
- (8) how well bottom plugged

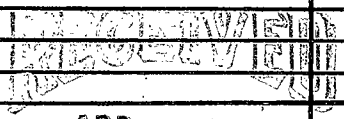


APR 20 1976

DRILLERS REMARKS:

If well telescopes please sketch and show depths.

GROUND LEVEL

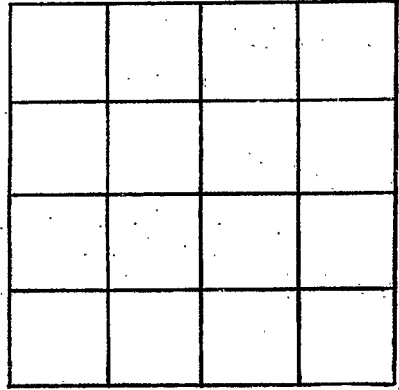

SECTION _____

Please indicate well location X.

ADDITIONAL INFORMATION

If more than one screen, show locations of each on sketch.