

WAYNE  
N 300  
6-10-76

MISSISSIPPI  
 BOARD OF WATER COMMISSIONERS  
 416 North State Street  
 13<sup>P</sup> Jackson, Mississippi 39201

WATER WELL DRILLERS LOG

June 10 1976 Porter Drilling Co. Wayne  
 date well completed firm name county well located

LANDOWNER: James Cochran  
500 Galea Dr  
Waynesboro Miss  
 (mailing address)

| description of formations encountered | from | to |
|---------------------------------------|------|----|
| clay sand                             | 0    | 8  |
| clay                                  | 8    | 30 |
| sand & clay                           | 30   | 45 |
| clay                                  | 45   | 63 |
| sand                                  | 63   | 90 |
| stagnant white<br>silty in sand       |      |    |

WELL LOCATION:  
 sec. 17 T 20 N R. 7 E  
3 miles W of Waynesboro  
 (distance) (direction) (nearest town)

WELL PURPOSE: Camp  
 (home, irrigation, municipal, industrial)

WELL COMPLETION DATA:  
 (1) diameter (inches) 2"  
 (2) total depth (feet) 90'  
 (3) static water level (feet) 30 (below top of ground)  
 (4) casing P.V.C. 80'  
 (material) (depth)  
2' if telescope see back.  
 (size)  
 (5) screen 10' 80  
 (length) (depth to top)  
2" P.V.C.  
 (size) (material)  
 (6) pump 3/4 12  
 (HP) (yield gpm)  
elec.  
 (type power)  
 (7) electric log no  
 (yes or no)  
 (organization running log)

back wash valve on  
 end of screen & shell  
 logs above  
 1/2" 1" P.V.C. logs  
 pipe

(8) how well bottom plugged  
back wash valve


DRILLERS REMARKS:

RECEIVED

AUG 9 - 1976

If well telescopes please sketch and show depths.

GROUND LEVEL

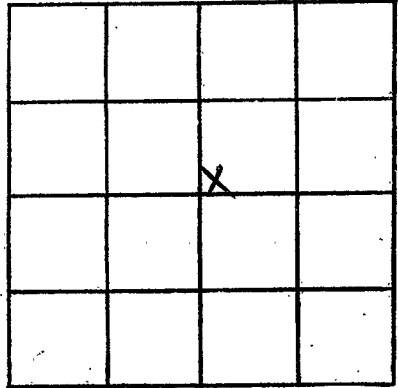

SECTION 17

Please indicate well location X.

ADDITIONAL INFORMATION

If more than one screen, show locations of each on sketch.