

WAYNE
 N 2053
 E-11-77

MISSISSIPPI
 BOARD OF WATER COMMISSIONERS
 416 North State Street
 Jackson, Mississippi 39201

WATER WELL DRILLERS LOG

Feb 11 1977 *Porter Drilling* *Madison*
 date well completed firm name county well located

LANDOWNER: *J. D. Conley*

Box 57 Magnolia
 (mailing address)

WELL LOCATION:
 sec 8 - T 20 N R 7 E
3 miles W of Magnolia
 (distance) (direction) (nearest town)

WELL PURPOSE:
 (home, irrigation, municipal, industrial)

- WELL COMPLETION DATA:
- (1) diameter (inches) 2"
 - (2) total depth (feet) 115'
 - (3) static water level (feet) 66 (below above top of ground)
 - (4) casing PVC 110'
(material) (depth)
2" if telescope see back.
(size)
 - (5) screen 5' 110'
(length) (depth to top)
1 1/4" 8 alt ss.
(size) (material)
 - (6) pump 1 1/2 6
(HP) (yield gpm)
elec
(type power)
 - (7) electric log no
(yes or no)
(organization running log)
 - (8) how well bottom plugged
back small valve

description of formations encountered	depth	
	from	to
<i>Clay</i>	<i>0</i>	<i>17</i>
<i>clay & sand layers</i>	<i>17</i>	<i>25</i>
<i>clay</i>	<i>25</i>	<i>25</i>
<i>clay & sand</i>	<i>25</i>	<i>115</i>
<i>86' 1" P.V.C. deep pipe</i>		
<i>1 1/4" mesh wash valve on end of screen & shell</i>		
<i>logs above</i>		

RECEIVED


APR 6 1977

MISS. Bd. OF WATER COMMISSIONERS

DRILLERS REMARKS:

If well telescopes please sketch and show depths.

GROUND LEVEL

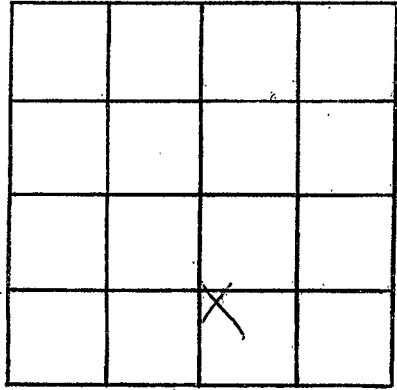

SECTION 8

Please indicate well location X.

ADDITIONAL INFORMATION

If more than one screen,
show locations of each on sketch.