

Wayne
 N 204
 3/77

MISSISSIPPI
 BOARD OF WATER COMMISSIONERS
 416 North State Street
 Jackson, Mississippi 39201

WATER WELL DRILLERS LOG

March 77 date well completed
 J.R. Grunwaldt Drilling firm name
 Wayne county well located

LANDOWNER:
 J.O. Phillips
 Waynesboro, Miss.
 (mailing address)

WELL LOCATION:
 sec. 7 T. 8 N. R. 7 E. S. 4
 8.4 miles W. Waynesboro, Miss.
 (distance) (direction) (nearest town)

WELL PURPOSE:
 (home, irrigation, municipal, industrial)

- WELL COMPLETION DATA:
- (1) diameter (inches) 4
 - (2) total depth (feet) 120
 - (3) static water level (feet) 50 below top of ground.
 - (4) casing PVC 100
 (material) (depth)
 (size) if telescope see back.
 - (5) screen 15 100
 (length) (depth to top)
2xood PVC
 (size) (material)
 - (6) pump 1 8
? (HP) (yield gpm)
 (type power)
 - (7) electric log No
 (yes or no)
 (organization running log)
 - (8) how well bottom plugged

description of formations encountered	from	to
Red sand	0	10
White chalk	10	20
sand	20	22
Yellow Chalk	22	26
" "	26	30
" "	30	40
sand	40	42
White Chalk	42	50
" "	50	60
" "	60	70
" "	70	75
Hard sand	75	80
" "	80	90
" "	90	100
" "	100	110
" "	110	120


RECEIVED
 JUL 25 1977

MISS. Bd. OF WATER COMM.

DRILLERS REMARKS:

If well telescopes please sketch and show depths.

GROUND LEVEL

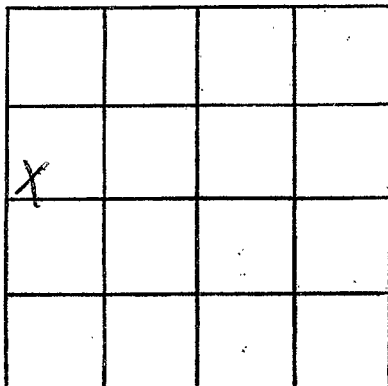

SECTION 7

Please indicate well location X.

ADDITIONAL INFORMATION

If more than one screen,
show locations of each on sketch.