

WAYNE
 N 2015
 4-29-77

MISSISSIPPI
 BOARD OF WATER COMMISSIONERS
 416 North State Street
 Jackson, Mississippi 39201

WILWAY WATER WELL DRILLERS LOG
 RT. 2, BOX 37
 WAYNESBORO, MISS. 39367

April 29
 date well completed

Wayne
 firm name

Wayne
 county well located

LANDOWNER:
 Rolston Davis
 Waynesboro Miss
 (mailing address)

description of formations encountered	from	to
	Sand	0

WELL LOCATION:
 sec. 10 T 8 N R 7 E
 1 miles W of Willow
 (distance) (direction) (nearest town)

Rock	12	16
Blue Clay	16	20
Jummy Rock & Clay	20	28

WELL PURPOSE: Home
 (home, irrigation, municipal, industrial)

Blue Clay	28	35
-----------	----	----

WELL COMPLETION DATA:
 (1) diameter (inches) 4" x 2"
 (2) total depth (feet) 140'
 (3) static water level (feet) 18' below top of ground.
 (4) casing PVC 4" - 18' 2" - 110'
 (material) (depth)
 (size) if telescope see back.
 (5) screen (length) (depth to top)
 (size) (material)
 (6) pump 3/4 15
 (HP) (yield gpm)
 110 AC
 (type power)
 (7) electric log No
 (yes or no)
 (organization running log)
 (8) how well bottom plugged

Rock & Clay	35	60
Clay	60	112
Honey Comb Rock	112	129
Spongy Honey Comb Bhenks	129	140


RECEIVED
 MAY 21 1977

MISS. Bd. OF WATER COMMISSIONERS

DRILLERS REMARKS:

If well telescopes please
sketch and show depths.

GROUND LEVEL

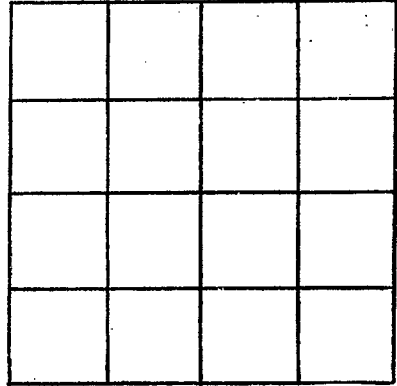

SECTION _____

Please indicate well location X.

ADDITIONAL INFORMATION

If more than one screen,
show locations of each on sketch.