

WAYNE
N
5-6-77

MISSISSIPPI
BOARD OF WATER COMMISSIONERS
416 North State Street
Jackson, Mississippi 39201

WATER WELL DRILLERS LOG

May 6
date well completed

McLAIN WATER WELL SERVICE
RI. 2, firm name;
WAYNESBORO, MISS. 39367

Wayne
county/well located


LANDOWNER:	description of formations encountered	from	to
Dick Sanderson Waynesboro Miss (mailing address)			
WELL LOCATION:	Sand & Same Clay	6	25
sec. 17 T 8 N R 7 W 4 miles W of Whoro (distance) (direction) (nearest town)	Sand	25	36
WELL PURPOSE: Home (home, irrigation, municipal, industrial)	Clay	36	78
WELL COMPLETION DATA:	Sand & Clay	78	82
(1) diameter (inches) 2"	Med. Sand	82	89
(2) total depth (feet) 39'			
(3) static water level (feet) 47' below top of ground.			
(4) casing PVC 84' (material) (depth) 2" if telescope see back. (size)			
(5) screen 5' R4' (length) (depth to top) 2" PVC .008 (size) (material)			
(6) pump 1 12 (HP) (yield gpm) 110 AC (type power)			
(7) electric log No (yes or no) (organization running log)			
(8) how well bottom plugged			
DRILLERS REMARKS:			

RECEIVED
MAY 31 1977

MISS. BD. OF WATER COMMISSIONERS

If well telescopes please
sketch and show depths.

GROUND LEVEL

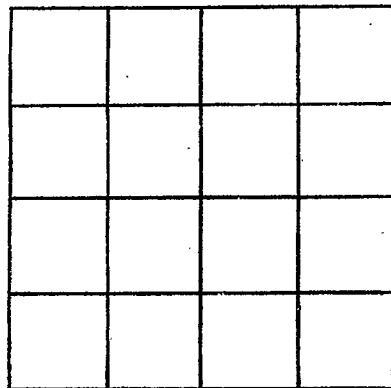

SECTION _____

Please indicate well location X.

ADDITIONAL INFORMATION

Series of horizontal lines for entering additional information.

If more than one screen,
show locations of each on sketch.