

WAYNE
 N 2057
 6-29-77

MISSISSIPPI
 BOARD OF WATER COMMISSIONERS
 416 North State Street
 Jackson, Mississippi 39201

13P

WATER WELL DRILLERS LOG

WAIN WATER WELL SERVICE

Wayne

June 29 1977
 date well completed

RT. 6 BOX 32
 firm name
 WAYNESBORO, MISS. 39367

county well located

LANDOWNER:

Clyde Renette

Waynesboro, Miss.
 (mailing address)

description of formations encountered

from to

Fill Dirt	0	4
Sand	4	21
Rock + Clay	21	24
Blue Clay	24	35
Rock + Heavy Clay	35	45
Blue Clay	45	50
Rock + Clay	50	65
Blue Clay	65	105
Honey Comb Rock	105	131

WELL LOCATION:

sec. 10 T 8 N R 7 E
 1 miles W of Wilboro
 (distance) (direction) (nearest town)

WELL PURPOSE: Business
 (home, irrigation, municipal, industrial)

WELL COMPLETION DATA:

- (1) diameter (inches) 4" x 2"
- (2) total depth (feet) 131'
- (3) static water level (feet) 25' below top of ground
- (4) casing PVC 4" - 30' 2" - 107'
 (material) (depth)
- (size) if telescope see back.
- (5) screen None
 (length) (depth to top)
- (size) (material)
- (6) pump 1 12
 (HP) (yield gpm)
- 220 AC
 (type power)
- (7) electric log NO
 (yes or no)
- (organization running log)
- (8) how well bottom plugged


DRILLERS REMARKS:

RECEIVED
 JUN 29 1977

MISS. BD. OF WATER COMM.

If well telescopes please sketch and show depths.

GROUND LEVEL

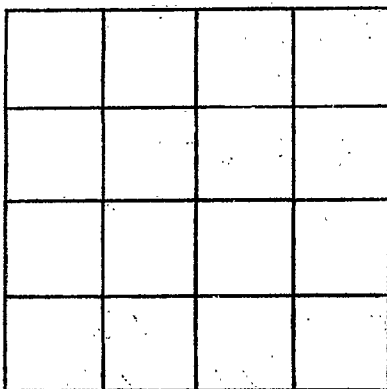

SECTION _____

Please indicate well location X.

ADDITIONAL INFORMATION

If more than one screen, show locations of each on sketch.