

WAYNE
 N 2018
 1-17-78

MISSISSIPPI
 BOARD OF WATER COMMISSIONERS
 416 North State Street
 Jackson, Mississippi 39201

WATER WELL DRILLERS LOG

JAN 17 1978 McILWAIN WATER WELL SERVICE Wayne
 date well completed RT. 2, Box 37 county well located
 WAYNESBORO, MISS. 39367

LANDOWNER:
 Galmadge Dalton
 Waynesboro Miss.
 (mailing address)

description of formations encountered	from	to
Red Clay	0	12
Sand & Clay	12	44
Clay	44	65
Sand & Clay	65	75
Clay	75	123
SAND	123	145

WELL LOCATION:
 sec. 28 T. 8 N R. 7 E
 3 1/2 miles SW of W'boro.
 (distance) (direction) (nearest town)

WELL PURPOSE: home
 (home, irrigation, municipal, industrial)

- WELL COMPLETION DATA:
- (1) diameter (inches) 2"
 - (2) total depth (feet) 145'
 - (3) static water level (feet) 94' below top of ground.
 - (4) casing PVC 140' (material) (depth)
 2" (size) If telescope see back.
 - (5) screen 5' 140' (length) (depth to top)
 2" PVC .088 (size) (material)
 - (6) pump 2 (HP) 8 (yield gpm)
 220 AC (type power)
 - (7) electric log No (yes or no)
- (organization running log)
- (8) how well bottom plugged


DRILLERS REMARKS:

RECEIVED
 APR 24 1978

MISS. BD. OF WATER COMMISSIONERS

If well telescopes please
sketch and show depths.

GROUND LEVEL

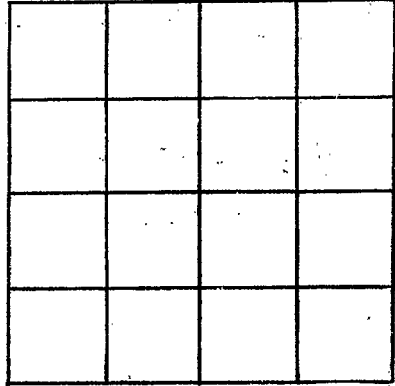

SECTION _____

Please indicate well location X.

ADDITIONAL INFORMATION

If more than one screen,
show locations of each on sketch.