

WAYNE

N 209

2-21-78

MISSISSIPPI
 BOARD OF WATER COMMISSIONERS
 416 North State Street
 Jackson, Mississippi 39201

WATER WELL DRILLERS LOG

Job-29

1978 McLWAIN WATER WELL SERVICE

Wayne

date well completed

RT. #17 BOX 37

county well located

WAYNESBORO, MISS. 39367

LANDOWNER:

Glynn Bynum
 Waynesboro Miss
 (mailing address)

description of formations encountered

from

to

	Sandy Clay	0	10
	Clay	10	14
	Sand	14	28
	Sand & Clay	28	37
	Clay	37	58
	Sand & Clay	58	85
	Med sand	85	105

WELL LOCATION:

sec. 7 T. 8 N. R. 7 E.
 S W
 5 miles W of Willow
 (distance) (direction) (nearest town)

WELL PURPOSE: Home
 (home, irrigation, municipal, industrial)

WELL COMPLETION DATA:

- (1) diameter (inches) 2"
- (2) total depth (feet) 105'
- (3) static water level (feet) 47' below top of ground
- (4) casing PVC 100"
 (material) (depth)
 2" (size) if telescope see back.
- (5) screen 5' 100"
 (length) (depth to top)
 2" PVC .002
 (size) (material)
- (6) pump 1 11
 (HP) (yield gpm)
 220 AC
 (type power)
- (7) electric log No
 (yes or no)

(organization running log)

(8) how well bottom plugged

DRILLERS REMARKS:


RECEIVED

APR 24 1978

MISS. BD. OF WATER COMMISSIONERS

If well telescopes please sketch and show depths.

GROUND LEVEL

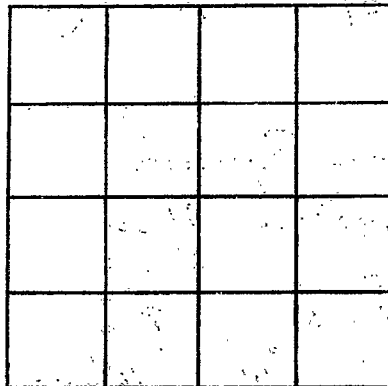

SECTION _____

Please indicate well location X.

ADDITIONAL INFORMATION

If more than one screen,
show locations of each on sketch.