

WAYNE

N 2000

5/10/78

MISSISSIPPI BOARD OF WATER COMMISSIONERS 416 North State Street Jackson, Mississippi 39201

WATER WELL DRILLERS LOG

May 10 1978 date well completed Porter Drilling Co firm name Wayne county well located

LANDOWNER: Allen Timber Co
Wainesboro Miss (mailing address)
WELL LOCATION: sec 24 T 8 N R 7 E
1/4 miles S of Wainesboro (distance) (direction) (nearest town)

Table with 3 columns: description of formations encountered, from, to. Rows include: wet sand (0-14), blue clay (14-25), wet siltstone (25-35), blue clay (35-54), wet siltstone (54-66), sand (66-71)

WELL PURPOSE: industrial (home, irrigation, municipal, industrial)

skull top above screen
42' 1" PVC drop pipe

WELL COMPLETION DATA:
(1) diameter (inches) 2"
(2) total depth (feet) 71'
(3) static water level (feet) 19' below top of ground
(4) casing PVC 67' (material) (depth)
2" (size) If telescope see back.
(5) screen 4' 67' (length) (depth to top)
2" (size) galv SS (material)
(6) pump 1 (HP) 15 (yield gpm)
elec (type power)
(7) electric log no (yes or no)
(organization running log)

(8) how well bottom plugged 1/4 inch mesh valve


DRILLERS REMARKS:

RECEIVED JUN 19 1978

MISS. BD. OF WATER

If well telescopes please sketch and show depths.

GROUND LEVEL

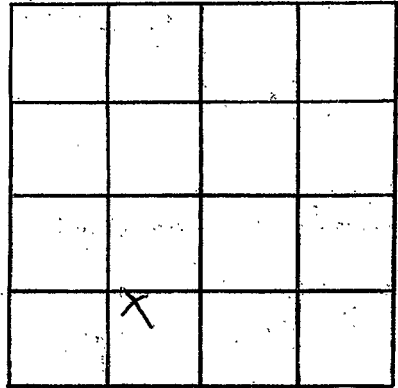

SECTION 24

Please indicate well location X.

ADDITIONAL INFORMATION

If more than one screen, show locations of each on sketch.