

WAYNE
 N 3001
 12-30-78

MISSISSIPPI
 BOARD OF WATER COMMISSIONERS
 416 North State Street
 Jackson, Mississippi. 39201

WATER WELL DRILLERS LOG
 McILWAIN WATER WELL SERVICE

DEC. 30 1978 RT. 2 BOX 37 Wayne
 date well completed WAYNESBORO, MISS. 39367 county well located

LANDOWNER:	description of formations encountered	from	to
RAY GATLIN			
Waynesboro Miss (mailing address)	Sand	10	10 1/2
WELL LOCATION: sec. <u>1</u> T. <u>8</u> N. R. <u>7</u> E <u>1</u> miles N of W'boro (distance) (direction) (nearest town)	Grey Clay	10 1/2	15
	Rock	18	18
WELL PURPOSE: <u>Home</u> (home, irrigation, municipal, industrial)	White Clay	17	20
WELL COMPLETION DATA:	Rock	20	22
(1) diameter (inches) <u>2"</u>	Limy Clay	22	24
(2) total depth (feet) <u>44'</u>	Sand	24	26
(3) static water level (feet) <u>28'</u> below top of ground.	Clay	26	27
(4) casing <u>PVC</u> <u>39'</u> (material) (depth)	Sand	27	29
<u>2"</u> If telescope see back. (size)	Clay	29	29 1/2
(5) screen <u>5'</u> <u>39'</u> (length) (depth to top)	SAND	29 1/2	44
<u>2"</u> <u>PVC</u> (size) (material)			
(6) pump <u>1/2</u> <u>10</u> <u>220</u> (HP) (yield gpm) <u>770 AC</u> (type power)			
(7) electric log <u>No</u> (yes or no)			
(organization running log)			
(8) how well bottom plugged			


DRILLERS REMARKS:

RECEIVED
 JAN 16 1978

MISS. DEPT. OF WATER CONTROL

If well telescopes please sketch and show depths.

GROUND LEVEL

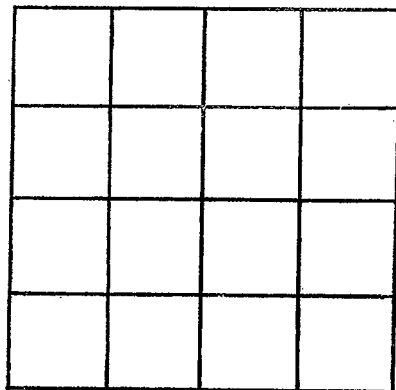

SECTION _____

Please indicate well location X.

ADDITIONAL INFORMATION

If more than one screen,
show locations of each on sketch.