

WAYNE

N *W*

12-14-78

MISSISSIPPI
BOARD OF WATER COMMISSIONERS
416 North State Street
Jackson, Mississippi 39201

WATER WELL DRILLERS LOG

Dec 14 1978 date well completed

Bohr Drilling, Inc. firm name

Wayne county well located

LANDOWNER: *Colden Mc Drew*

description of formations encountered

from

to

At 5 Box 111

Waynesboro Miss.
(mailing address)

WELL LOCATION:

sec. 11 T 8 N R 7 E

1/2

miles

W

Waynesboro

(distance)

(direction)

(nearest town)

WELL PURPOSE:

(home, irrigation, municipal, industrial)

WELL COMPLETION DATA:

(1) diameter (inches)

2"

(2) total depth (feet)

135'

(3) static water level (feet)

24' (below top of ground)

(4) casing

steel

108'

(material)

(depth)

2'

(size)

If telescope see back.

(5) screen

none used

(length)

(depth to top)

(size)

(material)

(6) pump

1

(HP)

1.5

(yield gpm)

also

(type power)

(7) electric log

no

(yes or no)

(organization running log)

(8) how well bottom plugged

open

DRILLERS REMARKS:


Miss. Board of Water Comm.

FEB 8 1979

RECEIVED

If well telescopes please
sketch and show depths.

GROUND LEVEL

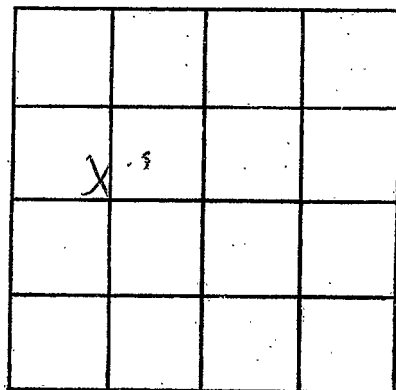

SECTION

11

Please indicate well location X.

ADDITIONAL INFORMATION

If more than one screen,
show locations of each on sketch.