

WAYNE

N 2055

7-6-79

MISSISSIPPI BOARD OF WATER COMMISSIONERS  
416 North State Street  
Jackson, Mississippi 39201

### WATER WELL DRILLERS LOG

7-6-1979 date well completed  
McITWAIN WATER WELL SERVICE RT firm name BOX 34  
Waynesboro, MISS 39367  
Wayne county well located

LANDOWNER:  
Wayne County Circuit  
Waynesboro Miss.  
(mailing address)

WELL LOCATION:  
sec. 1 T 8 N R 7 E  
0 miles (distance) (direction) of Waynesboro (nearest town)

WELL PURPOSE: Home  
(home, irrigation, municipal, industrial)

- WELL COMPLETION DATA:
- (1) diameter (inches) 2"
  - (2) total depth (feet) 114'
  - (3) static water level (feet) 80' below top of ground.
  - (4) casing PVC (material) 104' (depth)
  - 2" (size) if telescope see back.
  - (5) screen 10' (length) 104' (depth to top)
  - 2" (size) PVC .008 (material)
  - (6) pump 1 (HP) 6 (yield gpm)
  - 220 AC (type power)
  - (7) electric log No (yes or no)

(organization running log)

(8) how well bottom plugged

DRILLERS REMARKS:

| description of formations encountered | from          | to            |
|---------------------------------------|---------------|---------------|
| <u>Red Sand</u>                       | <u>0</u>      | <u>12</u>     |
| <u>Yellow Sand</u>                    | <u>12</u>     | <u>18</u>     |
| <u>White Coarse Sand</u>              | <u>18</u>     | <u>25</u>     |
| <u>Sand + Clay</u>                    | <u>25</u>     | <u>36</u>     |
| <u>Blue Clay</u>                      | <u>36</u>     | <u>49</u>     |
| <u>Rock + Clay</u>                    | <u>49</u>     | <u>51 1/2</u> |
| <u>Rock + Shells</u>                  | <u>51 1/2</u> | <u>60</u>     |
| <u>Brown Clay</u>                     | <u>60</u>     | <u>65</u>     |
| <u>Rock</u>                           | <u>65</u>     | <u>68</u>     |
| <u>Clay</u>                           | <u>68</u>     | <u>69 1/2</u> |
| <u>Rock</u>                           | <u>69 1/2</u> | <u>71</u>     |
| <u>Fine Sand</u>                      | <u>71</u>     | <u>72</u>     |
| <u>Rock</u>                           | <u>72</u>     | <u>74</u>     |
| <u>Limy Clay + Shells</u>             | <u>74</u>     | <u>81</u>     |
| <u>Vecksburg</u>                      | <u>81</u>     | <u>114</u>    |


Miss. Board of Water Comm.

AUG 9 1979

# RECEIVED

If well telescopes please  
sketch and show depths.

GROUND LEVEL

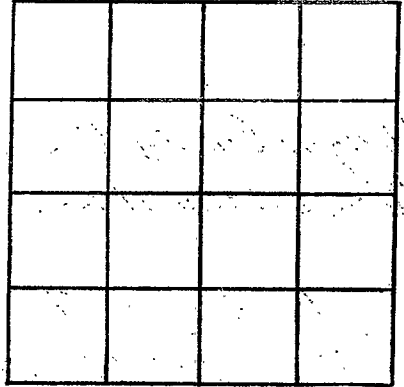

SECTION \_\_\_\_\_

Please indicate well location X.

ADDITIONAL INFORMATION

If more than one screen,  
show locations of each on sketch.