

Wayne  
N. D. D.  
8-31-79

MISSISSIPPI  
BOARD OF WATER COMMISSIONERS  
416 North State Street  
Jackson, Mississippi 39201

WATER WELL DRILLERS LOG

Aug 31 1979 Porter Drilling Wayne  
date well completed firm name county well located

LANDOWNER: <u>Clyde Mills</u> <u>Box 3</u>	description of formations encountered	from	to
<u>Waynesboro Miss.</u> (mailing address)	<u>sand</u> <u>shale to clay</u>	<u>0</u>	<u>23</u>
WELL LOCATION: sec. <u>13</u> T. <u>8</u> (N) S. R. <u>7</u> E. (W) <u>2</u> miles <u>S</u> <u>Waynesboro</u> (distance) (direction) (nearest town)			
WELL PURPOSE: <u>Home</u> (home, irrigation, municipal, industrial)			
WELL COMPLETION DATA:			
(1) diameter (inches) <u>2"</u>			
(2) total depth (feet) <u>23'</u>			
(3) static water level (feet) <u>6</u> below above top of ground.			
(4) casing <u>P.V.C. 18'</u> (material) (depth)			
<u>2"</u> (size) if telescope see back.			
(5) screen <u>5'</u> <u>18'</u> (length) (depth to top)			
<u>2"</u> <u>90% P.V.C.</u> (size) (material)			
(6) pump <u>1/2</u> <u>2</u> (HP) (yield gpm)			
<u>elec.</u> (type power)			
(7) electric log <u>not</u> (yes or no)			
(organization running log)			
(8) how well bottom plugged <u>plugged</u>			
DRILLERS REMARKS:			


Miss. Board of Water Comm.

SEP 10 1979

RECEIVED

escopes please  
and show depths.

GROUND LEVEL

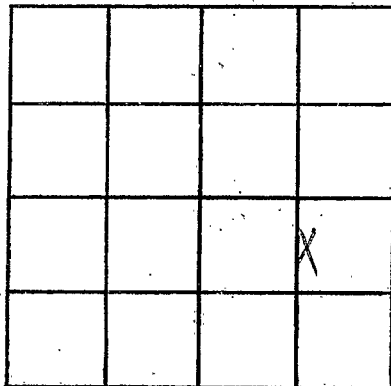

SECTION 13

Please indicate well location X.

ADDITIONAL INFORMATION

If more than one screen,  
show locations of each on sketch.