

WAYNE
 N 3057
 6-14-79

MISSISSIPPI
 BOARD OF WATER COMMISSIONERS
 416 North State Street
 Jackson, Mississippi 39201

WATER WELL DRILLERS LOG

June 14 1979 Quiter Drilling Wayne
 date well completed firm name county well located

LANDOWNER: Oliver Armstrong
315 21/2 Ave St.
Waynesboro Miss
 (mailing address)

description of formations encountered	depth	
	from	to
Clas	0	11
Coarse sand	11	22
Stratification		
Blas		

WELL LOCATION:
 sec. 12 T. 8 N. R. 7 E
Waynesboro, Miss
 (distance) miles (direction) of (nearest town)

WELL PURPOSE: Home
 (home, irrigation, municipal, industrial)

- WELL COMPLETION DATA:
- (1) diameter (inches) 2"
 - (2) total depth (feet) 22
 - (3) static water level (feet) 4 below top of ground. above
 - (4) casing PVC 17'
 (material) (depth)
2" If telescope see back.
 (size)
 - (5) screen 5' 17
 (length) (depth to top)
2" cast PVC
 (size) (material)
 - (6) pump 1/2 12
 (HP) (yield gpm)
aler
 (type power)
 - (7) electric log no
 (yes or no)
 (organization running log)

(8) how well bottom plugged
1 1/2" lead wood w/che

DRILLERS REMARKS:


Miss. Board of Water Comm.

JUN 18 1979

RECEIVED

If well telescopes please sketch and show depths.

GROUND LEVEL

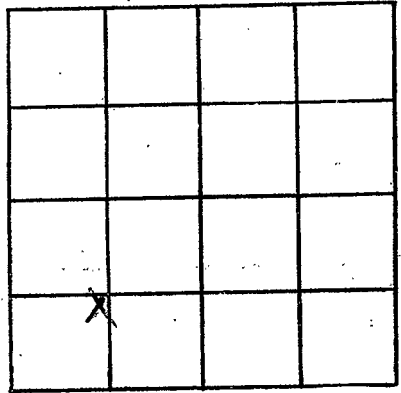

SECTION 12

Please indicate well location X.

ADDITIONAL INFORMATION

If more than one screen, show locations of each on sketch.