

Wayne
N 2022
May 23, 1979

MISSISSIPPI
BOARD OF WATER COMMISSIONERS
416 North State Street
Jackson, Mississippi 39201
WATER WELL DRILLERS LOG

Completed 3/19 79 Quinta B. Pullen firm name 21 years county well located

LANDOWNER: John R. ... description of formations encountered
Haywood, Miss. (mailing address)
WELL LOCATION: sec 24 T 2 N R 7 E
1 1/2 miles S Haywood (distance) (direction) (nearest town)
WELL PURPOSE: ... (home, irrigation, municipal, industrial)
WELL COMPLETION DATA:

- (1) diameter (inches) 2"
 - (2) total depth (feet) 179'
 - (3) static water level (feet) 21 ^{Below} top of ground above
 - (4) casing PVC (material) 154' (depth)
2" (size) if telescope see back.
 - (5) screen 5' (length) 154' (depth to top)
2" (size) galv. S.S. (material)
 - (6) pump 1 (HP) 15 (yield gpm)
slac (type power)
 - (7) electric log no (yes or no)
- (organization running log)
- (8) how well bottom plugged 2" hand drill

description of formations encountered	from	to
<u>sand</u>	<u>0</u>	<u>12</u>
<u>clay</u>	<u>12</u>	<u>30</u>
<u>shale</u>	<u>30</u>	<u>70</u>
<u>clay</u>	<u>70</u>	<u>75</u>
<u>fine sand</u>	<u>75</u>	<u>120</u>
<u>coarse sand</u>	<u>120</u>	<u>140</u>
<u>clay</u>	<u>140</u>	<u>167</u>

4" 1" PVC 27 ft

Miss. Board of Water Comm.


JUN 18 1979

DRILLERS REMARKS: _____

RECEIVED

If well telescopes please sketch and show depths.

GROUND LEVEL

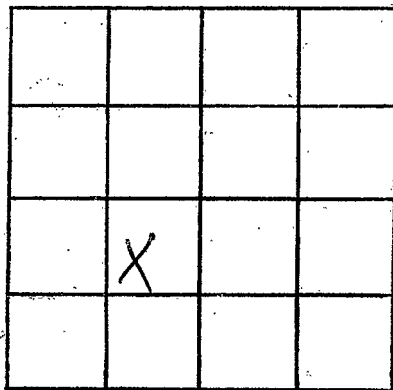

SECTION 24

Please indicate well location X.

ADDITIONAL INFORMATION

If more than one screen,
show locations of each on sketch.