

MISSISSIPPI DEPARTMENT OF NATURAL RESOURCES

Bureau of Land and Water Resources

Southport Mall

P.O. Box 10631

Jackson, Mississippi 39209

WATER WELL DRILLERS LOG

**WAYNE**  
**N** *200A*  
**8-4-80**

*Aug 4* 19*80* *Porter Drilling & Pipe* *Wayne*  
 date well completed firm name county well located

LANDOWNER	description of formations encountered	from	to
<i>Jay O dom</i> <i>At 3</i>	<i>sand</i>	<i>0</i>	<i>21</i>
<i>Waynesboro Miss</i> (mailing address)	<i>clay &amp; sand</i>	<i>21</i>	<i>30</i>
	<i>sand</i>	<i>30</i>	<i>39</i>
	<i>thin rock</i>		<i>39</i>
	<i>clay</i>	<i>39</i>	<i>48</i>
	<i>sand &amp; clay</i>	<i>48</i>	<i>61</i>
	<i>clay &amp; sand</i>	<i>61</i>	<i>63</i>
WELL LOCATION: sec <i>34</i> T <i>8</i> N <i>1</i> S R <i>7</i> E <i>1</i> W <i>3 1/2</i> miles S <i>Waynesboro</i> (distance) (direction) (nearest town)			
WELL PURPOSE: <i>None</i> (home, irrigation, municipal, industrial)			
WELL COMPLETION DATA: (1) diameter (inches) <i>2"</i> (2) total depth (feet) <i>61'</i> (3) static water level (feet) <i>41</i> <i>(below)</i> top of ground. <i>above</i> (4) casing <i>PVC</i> , <i>56'</i> (material) (depth) <i>2'</i> (size) If telescope see back. (5) screen <i>5'</i> , <i>56'</i> (length) (depth to top) <i>2"</i> , <i>bslot SS.</i> (size) (material) (6) pump <i>1</i> , <i>10</i> (HP) (yield gpm) <i>elec.</i> (type power) (7) electric log <i>no</i> (yes or no) (organization running log) (8) how well bottom plugged <i>2' sand blank</i>	<i>52' 1" P.V.C. drop pipe</i>		
DRILLERS REMARKS:			


DEPT. OF NATURAL RESOURCES  
 BUREAU OF LAND & WATER RESOURCES

SEP 24 1980

RECEIVED

If well telescopes please sketch and show depths.

GROUND LEVEL

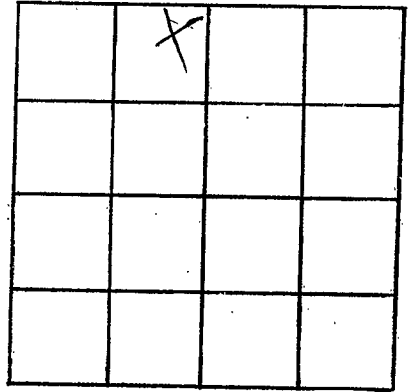

SECTION 34

Please indicate well location X.

ADDITIONAL INFORMATION

If more than one screen,  
show locations of each on sketch.