

This location is due West of Waynesboro

Wayne
N 20032
9-5-80

MISSISSIPPI
BOARD OF WATER COMMISSIONERS
416 North State Street
Jackson, Mississippi 39201

WATER WELL DRILLERS LOG



Sept 5 1980 Roy V. West Only Wayne
date well completed firm name county well located

LANDOWNER:	description of formations encountered	from	to
RAY DUNN Rt 4 Waynesboro (mailing address)			

WELL LOCATION:
sec. 6 T 8 N R 7 E
5 miles SW of Waynesboro
(distance) (direction) (nearest town)

WELL PURPOSE: HOME
(home, irrigation, municipal, industrial)

- WELL COMPLETION DATA:
- (1) diameter (inches) 2"
 - (2) total depth (feet) 115'
 - (3) static water level (feet) 42' below top of ground.
 - (4) casing PVC, 110' (material) (depth)
(size) If telescope see back.
 - (5) screen 5' length, 110' depth to top
1 1/4" stainless steel (size) (material)
 - (6) pump 1 (HP), 6 (yield gpm)
REA (type power)
 - (7) electric log NO (yes or no)
(organization running log)
 - (8) how well bottom plugged WASH VALVE

DEPT. OF NATURAL RESOURCES
BUREAU OF LAND & WATER RESOURCES


NOV 24 1980

RECEIVED

DRILLERS REMARKS:

If well telescopes please sketch and show depths.

GROUND LEVEL

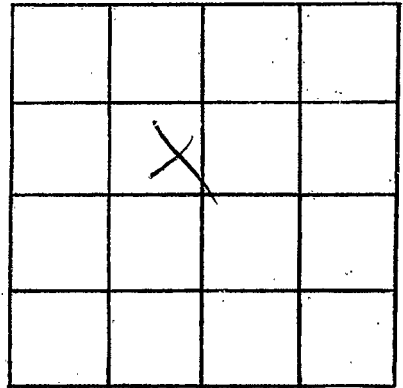

SECTION 6

Please indicate well location X.

ADDITIONAL INFORMATION

If more than one screen, show locations of each on sketch.