

MISSISSIPPI DEPARTMENT OF NATURAL RESOURCES

Bureau of Land and Water Resources

Southport Mall

P.O. Box 10631

Jackson, Mississippi 39209

WATER WELL DRILLERS LOG

Wayne  
N 5033  
11-11-80

4

Nov 11 1980 Porter Drilling & Log Wayne  
date well completed firm name county well located

LANDOWNER: Robert Holland  
At 5 Box 316  
Waynesboro, Miss.  
(mailing address)

description of formations encountered	depth	
	from	to
Clay	0	15
rock	15	16
2' Clay	16	24
med. sand	24	21
sub sand, clay	21	20

WELL LOCATION:  
sec. 7 T. 8 N R. 7 E  
S W  
4 miles W of Waynesboro  
(distance) (direction) (nearest town)

WELL PURPOSE: none  
(home, irrigation, municipal, industrial)

WELL COMPLETION DATA:

(1) diameter (inches) 2"

(2) total depth (feet) 21'

(3) static water level (feet) 48' below top of ground.

(4) casing PVC 76' (material) (depth)  
2" (size) if telescope see back.

(5) screen 5' 76' (length) (depth to top)  
2" bsbt. ss. (size) (material)

(6) pump 1 10 (HP) (yield gpm)  
elec. (type power)

(7) electric log no (yes or no)  
(organization running log)

62' 1" PVC drive pipe  
sheet piling about screen

(8) how well bottom plugged  
2' sand shank

DRILLERS REMARKS:


DEPT. OF NATURAL RESOURCES  
Bureau of LAND & WATER RESOURCES

DEC - 3 1980

RECEIVED

If well telescopes please  
sketch and show depths.

GROUND LEVEL

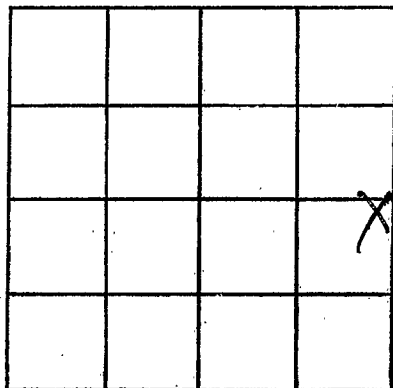

SECTION 7

Please indicate well location X.

ADDITIONAL INFORMATION

If more than one screen,  
show locations of each on sketch.