

MISSISSIPPI DEPARTMENT OF NATURAL RESOURCES

Bureau of Land and Water Resources

Southport Mall

P.O. Box 10631

Jackson, Mississippi 39209

WATER WELL DRILLERS LOG

WAYNE
N 2035
12-30-80
Dec 30 1980 Porter Drilling Wayne
date well completed firm name county well located

LANDOWNER: Jimmy Hayes
Pl 6
Waynesboro Miss
(mailing address)
WELL LOCATION:
sec. 1 T. 20 N. R. 7 E.
miles Nudge of Waynesboro
(distance) (direction) (nearest town)

description of formations encountered	from	to
<u>Clay</u>	<u>0</u>	<u>29</u>
<u>rock & water</u>	<u>29</u>	<u>65</u>
<u>Clay</u>	<u>65</u>	<u>67</u>
<u>sand</u>	<u>67</u>	<u>96</u>
<u>Clay</u>	<u>96</u>	<u>107</u>
<u>clay & hard rock</u>	<u>107</u>	<u>135</u>

WELL PURPOSE: home
(home, irrigation, municipal, industrial)

WELL COMPLETION DATA:
(1) diameter (inches) 2"
(2) total depth (feet) 135'
(3) static water level (feet) 75' below top of ground.
(4) casing galv. 109'
(material) (depth)
2" if telescope see back.
(size)
(5) screen none used
(length) (depth to top)
(size) (material)
(6) pump 1 1/2 10
(HP) (yield gpm)
elec.
(type power)
(7) electric log no
(yes or no)
(organization running log)

84' 1 1/4" galv. drive pipe

(8) how well bottom plugged open

DRILLERS REMARKS:


DEPT. OF NATURAL RESOURCES
BUREAU OF LAND & WATER RESOURCES

JAN 23 1981

RECEIVED

If well telescopes please sketch and show depths.

GROUND LEVEL

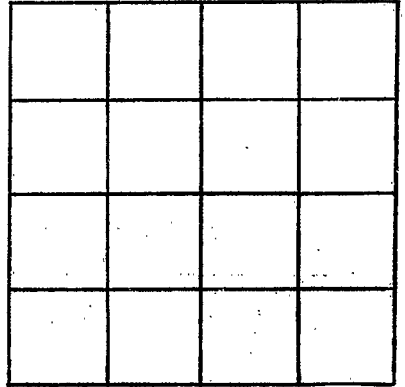

SECTION _____

Please indicate well location X.

ADDITIONAL INFORMATION

If more than one screen,
show locations of each on sketch.