

MISSISSIPPI DEPARTMENT OF NATURAL RESOURCES

Bureau of Land and Water Resources

Southport Mall

P.O. Box 10631

Jackson, Mississippi 39209

WATER WELL DRILLERS LOG

WAYNE
N 2030
6-16-81

June 16 1981 date well completed
 Central Drilling & Supply firm name
 Wayne county well located

LANDOWNER: Early Moyer
at 5
Waynesboro Miss
 (mailing/address)


description of formations encountered	from	to
Clay	0	11
Clay & sand	11	40
fine sandstone clay	40	76
stop on clay		

WELL LOCATION:
 sec. 6 T. 8 N. R. 7 E.
4 miles West Waynesboro
 (distance) (direction) (nearest town)

62' 1" P.V.C drop pipe

WELL PURPOSE: home
 (home, irrigation, municipal, industrial)


- WELL COMPLETION DATA:
- (1) diameter (inches) 2"
 - (2) total depth (feet) 76'
 - (3) static water level (feet) 47' below top of ground.
 - (4) casing P.V.C 71'
 (material) (depth)
2" if telescope see back.
 (size)
 - (5) screen 5' 71'
 (length) (depth to top)
2" galv S.S.
 (size) (material)
 - (6) pump 1 9
 (HP) (yield gpm)
elec.
 (type power)
 - (7) electric log no
 (yes or no)
 - (organization running log)
 - (8) how well bottom plugged
2" sand shank

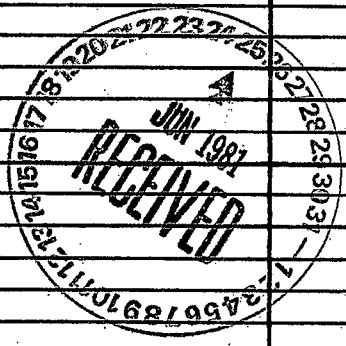

DRILLERS REMARKS:

If well telescopes please sketch and show depths.

GROUND LEVEL

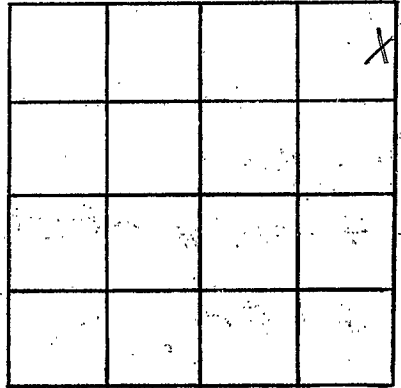

SECTION 6

Please indicate well location X.

ADDITIONAL INFORMATION

If more than one screen,
show locations of each on sketch.