

MISSISSIPPI DEPARTMENT OF NATURAL RESOURCES

Bureau of Land and Water Resources

Southport Mall

P.O. Box 10631

Jackson, Mississippi 39209

WATER WELL DRILLERS LOG

Wayne
N 2038
11-5-81

Nov. 5 1981 date well completed
Pete Drilling & Log firm name
Wayne county well located

LANDOWNER	description of formations encountered	from	to
Allen Walker	Clay	0	15
At 6 Bay 309 E	Clay & sand	15	20
Waynesboro Miss (mailing address)	Clay	20	27
WELL LOCATION:	Clay	27	30
sec 2/T 30 (N) R 7 E (W)	Clay	30	49
2 1/2 miles SW of Waynesboro (distance) (direction) (nearest town)	Clay	49	119
WELL PURPOSE: home (home, irrigation, municipal, industrial)	Clay	119	160
WELL COMPLETION DATA:	Clay & sand	160	90
(1) diameter (inches) 2"	red line red sand	90	96
(2) total depth (feet) 100'	small brown sand	96	102
(3) static water level (feet) 54' below top of ground.			
(4) casing PVC 95' (material) (depth)			
2" (size) if telescope see back.			
(5) screen 5' 95' (length) (depth to top)			
2" (size) ball SS (material)			
(6) pump 2 (HP) 12 (yield gpm)			
elec. (type power)			
(7) electric log no (yes or no)			
(organization running log)			
(8) how well bottom plugged			
2" sand above steel top			
DRILLERS REMARKS:			


DEPT. OF NATURAL RESOURCES
BUREAU OF LAND & WATER RESOURCES

NOV 25 1981

RECEIVED

If well telescopes please sketch and show depths.

GROUND LEVEL

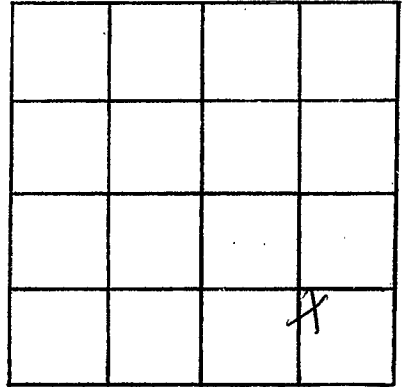

SECTION 21

Please indicate well location X.

ADDITIONAL INFORMATION

If more than one screen, show locations of each on sketch.