

MISSISSIPPI DEPARTMENT OF NATURAL RESOURCES

Bureau of Land and Water Resources

Southport Mall

P.O. Box 10631

Jackson, Mississippi 39209

WATER WELL DRILLERS LOG

WAYNE  
N 205  
8-17-81

Aug 17 1981 Boater Drilling & Log Wayne  
 date well completed firm name county well located

LANDOWNER: Tony Weaver  
Box 6 Box 2 Waynesboro  
Miss  
 (mailing address)

WELL LOCATION:  
 sec 32 T 8 (N) R 7 (E)  
3 miles N of Clara  
 (distance) (direction) (nearest town)

WELL PURPOSE: home  
 (home, irrigation, municipal, industrial)

- WELL COMPLETION DATA:
- (1) diameter (inches) 2
  - (2) total depth (feet) 106'
  - (3) static water level (feet) 66 below top of ground.
  - (4) casing P.V.C. 101'  
 (material) (depth)  
2"  
 (size) If telescope see back.
  - (5) screen 5' 101'  
 (length) (depth to top)  
2" 6 slot S.S.  
 (size) (material)
  - (6) pump 1 8  
 (HP) (yield gpm)  
elec.  
 (type power)
  - (7) electric log no  
 (yes or no)  
 (organization running log)
  - (8) how well bottom plugged 2' sand stake


description of formations encountered	from	to
Clay	0	8
sand & clay	8	40
Clay	40	75
sand some clay	75	97
firm med sand	97	104
soft sand	104	106
82' 1" P.V.C. drop pipe		

DEPT. OF NATURAL RESOURCES  
 BUREAU OF LAND & WATER RESOURCES  
 SEP - 9 1981  
 RECEIVED

DRILLERS REMARKS:

If well telescopes please sketch and show depths.

GROUND LEVEL

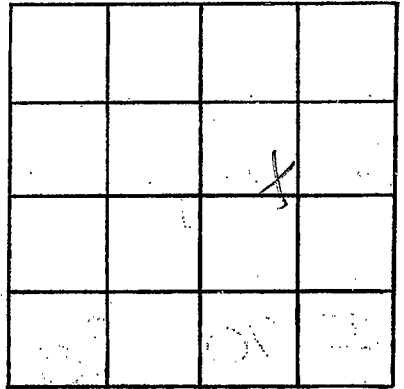

SECTION 32

Please indicate well location X.

ADDITIONAL INFORMATION

A series of horizontal lines for entering additional information.

If more than one screen, show locations of each on sketch.