

MISSISSIPPI DEPARTMENT OF NATURAL RESOURCES

Bureau of Land and Water Resources

Southport Mall

P.O. Box 10631

Jackson, Mississippi 39209

WATER WELL DRILLERS LOG

4

Wayne
No. 1000

June 16 1982
date well completed

Porter Drilling & Log
firm name

Wayne
county well located

LANDOWNER: Mack Barrett
At 3 Waynesboro, Miss

description of formations encountered	from	to
Clay	0	45
sand	45	49
Clay some sand	49	58
Clay	58	65
sand	65	69
Clay	69	78
soft sand	78	84
fine sand	84	89
brack sand	89	95
strat. voids		
still in sand		

(mailing address)
WELL LOCATION:
sec. 17 T 20 N R 7 E
3 miles W of Waynesboro
(distance) (direction) (nearest town)

WELL PURPOSE:
(home, irrigation, municipal, industrial)

WELL COMPLETION DATA:
(1) diameter (inches) 2"
(2) total depth (feet) 95'
(3) static water level (feet) 63 below top of ground.
(4) casing PVC 90' (material) (depth)
2' (size) If telescope see back.
(5) screen 5' 90' (length) (depth to top)
2" bobt. S.S. (size) (material)
(6) pump 3/4 5 (HP) (yield gpm)
elec. (type power)
(7) electric log no (yes or no)
(organization running log)
(8) how well bottom plugged 2" sand strat

82' 1" P.V.C drops
pipe

DEPT. OF NATURAL RESOURCES
BUREAU OF LAND & WATER RESOURCES


JUN 16 1982

RECEIVED

DRILLERS REMARKS:

If well telescopes please sketch and show depths.

GROUND LEVEL

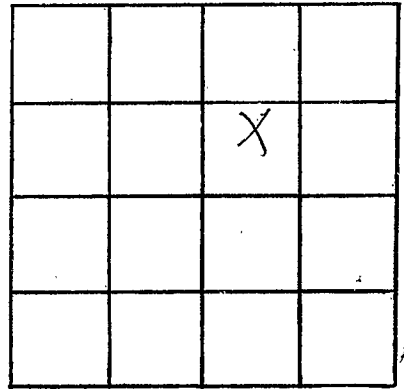

SECTION 17

Please indicate well location X.

ADDITIONAL INFORMATION

If more than one screen,
show locations of each on sketch.