

MISSISSIPPI DEPARTMENT OF NATURAL RESOURCES
Bureau of Land and Water Resources
 Southport Mall
 P.O. Box 10631
 Jackson, Mississippi 39209
WATER WELL DRILLERS LOG

Wayne
N
2041

Aug 17 1982 Booster Drilling & Log Wayne
 date well completed firm name county well located

LANDOWNER: Jimmie Bowen
1305 Sham St.
Waynesboro Miss
 (mailing address)

WELL LOCATION:
 sec. 12 T 8 N R 7 E
 (distance) miles (direction) of (nearest town)
in Waynesboro

WELL PURPOSE: home
 (home, irrigation, municipal, industrial)

WELL COMPLETION DATA:
 (1) diameter (inches) 4"
 (2) total depth (feet) 150
 (3) static water level (feet) 62 ^{below} _{above} top of ground.
 (4) casing steel, 115'
 (material) (depth)
4"
 (size) If telescope see back.
 (5) screen none used
 (length) (depth to top)
 (size) (material)
 (6) pump 2 33
 (HP) (yield gpm)
elec.
 (type power)
 (7) electric log no
 (yes or no)
 (organization running log)

description of formations encountered	from	to
sand	0	5
clay	5	23
sand	25	33
rock stratum	33	59
Waynesboro sand	59	102
clay	102	114
Tuckersburg rock	114	143
white clay	143	150
<u>10.5' 1 1/2" galv. pipe</u>		

(8) how well bottom plugged open

DRILLERS REMARKS:


DEPT. OF NATURAL RESOURCES
 BUREAU OF LAND & WATER RESOURCES

SEP - 1 1982

RECEIVED

If well telescopes please sketch and show depths.

GROUND LEVEL

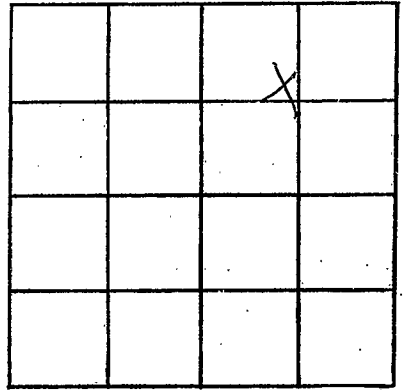

SECTION 12

Please indicate well location X.

ADDITIONAL INFORMATION

If more than one screen,
show locations of each on sketch.