

MISSISSIPPI DEPARTMENT OF NATURAL RESOURCES

Bureau of Land and Water Resources

Southport Mall

P.O. Box 10631

Jackson, Mississippi 39209

WATER WELL DRILLERS LOG

Wayne
N
2042

Sept 1 1982 date well completed
Bob Drilling Log firm name
Wayne county well located

LANDOWNER: Falmage Gatten

description of formations encountered

from to

at 5
Waynesboro Miss
(mailing address)

sand & clay	0	38
clay	38	45
silt & rock	45	49
clay	49	70
thin rock		70
clay	70	78
rocky	78	79
fine sand & clay	79	96
clay	96	100
thin rock		100
clay	100	140
fine sand	140	145
clay	145	156
sand & clay	156	176
fine sand	176	210
thin bed. course	210	216
soft med sand	216	225
stop at white		
stuck in sand		

WELL LOCATION:
sec 28 T 80 N R 7 E
S W
4 miles SW Waynesboro
(distance) (direction) (nearest town)

WELL PURPOSE: home
(home, irrigation, municipal, industrial)

WELL COMPLETION DATA:

- (1) diameter (inches) 2'
- (2) total depth (feet) 216'
- (3) static water level (feet) 93' (below above top of ground.)
- (4) casing PVC 2 1/2"
(material) (depth)
2' If telescope see back.
(size)
- (5) screen 5' 2 1/2"
(length) (depth to top)
2' galv. sis.
(size) (material)
- (6) pump 2 8
(HP) (yield gpm)
elec.
(type power)
- (7) electric log no
(yes or no)

(organization running log)

(8) how well bottom plugged
2' sand stake

DRILLERS REMARKS:


DEPT. OF NATURAL RESOURCES
BUREAU OF LAND & WATER RESOURCES

SEP 17 1982

RECEIVED

If well telescopes please sketch and show depths.

GROUND LEVEL

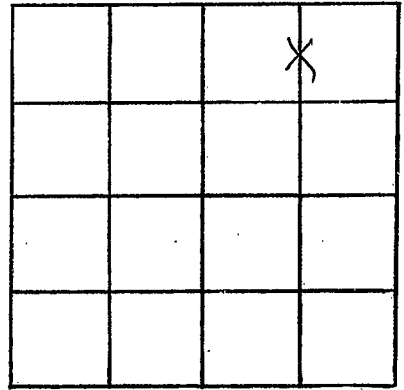

SECTION 28

Please indicate well location X.

ADDITIONAL INFORMATION

If more than one screen,
show locations of each on sketch.