

Wayne  
 N  
 2043

MISSISSIPPI DEPARTMENT OF NATURAL RESOURCES  
 Bureau of Land and Water Resources  
 Southport Mall  
 P.O. Box 10631  
 Jackson, Mississippi 39209  
**WATER WELL DRILLERS LOG**

6-2-83 1983 McDonald + Hill Wayne  
 date well completed firm name county well located

LANDOWNER:  
 SCOTT DAPER  
 PO  
 (mailing address)

description of formations encountered	from	to
CLAY	0	5
SAND	5	45
SAND SHALE	45	55
SHALE STRACK	55	90
FINE SAND	90	105
SHALE	105	165
SAND ST SHALE	165	300

WELL LOCATION:  
 sec. 1 T. 8 N. R. 7 E  
4 miles SOUTH of WAYNESBORO  
 (distance) (direction) (nearest town)

WELL PURPOSE:  
 (home, irrigation, municipal, industrial)

- WELL COMPLETION DATA:
- (1) diameter (inches) 4 1/2
  - (2) total depth (feet) 300'
  - (3) static water level (feet) 35 below above top of ground.
  - (4) casing PVC 165'  
 (material) (depth)  
4" If telescope see back.  
 (size)
  - (5) screen NONE  
 (length) (depth to top)  
 (size) (material)
  - (6) pump 1/2 7  
 (HP) (yield gpm)  
 (type power)
  - (7) electric log (yes or no) (no)  
 (organization running log)
  - (8) how well bottom plugged OPEN

DEPT. OF NATURAL RESOURCES  
 BUREAU OF LAND & WATER RESOURCES


JUN - 6 1983

RECEIVED

DRILLERS REMARKS:

If well telescopes please  
sketch and show depths.

GROUND LEVEL

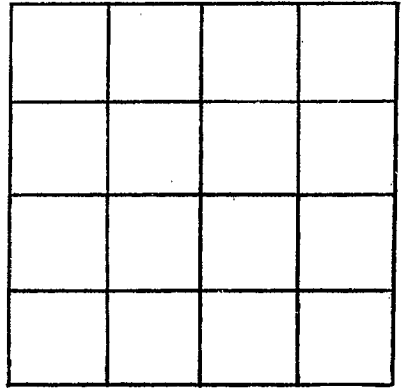

SECTION \_\_\_\_\_

Please indicate well location X.

ADDITIONAL INFORMATION

If more than one screen,  
show locations of each on sketch.